

**City of Prince George
HISTORY SHEET**

005809371

SHEET NUMBER

11167

Roll Number

Legal: LOT'S

3

BLOCK

D.L. 4040

PLAN 6427

Address:

3736

HART HWY

Sanitary Connection: #

11409

SIZE

4"

MATERIAL

A.C.

INV.

CONNECTED

Water Connection #

SIZE

20mm

MATERIAL

Cu

METER

CONNECTED

Storm Connection: #

SIZE

MATERIAL

INV.

CONNECTED

Cash Receipt No's:

WATER

SANITARY

1412

STORM

CURB FROM PROPERTY LINE

PAVEMENT WIDTH

B.C. HYDRO

UNDERGROUND CONNECTION


B.C. TELEPHONE

UNDERGROUND CONNECTION


INLAND GAS

Information Sheets:

Comments:

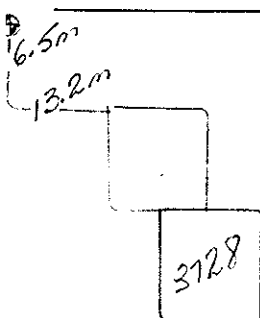

SITE PLAN N.T.S.

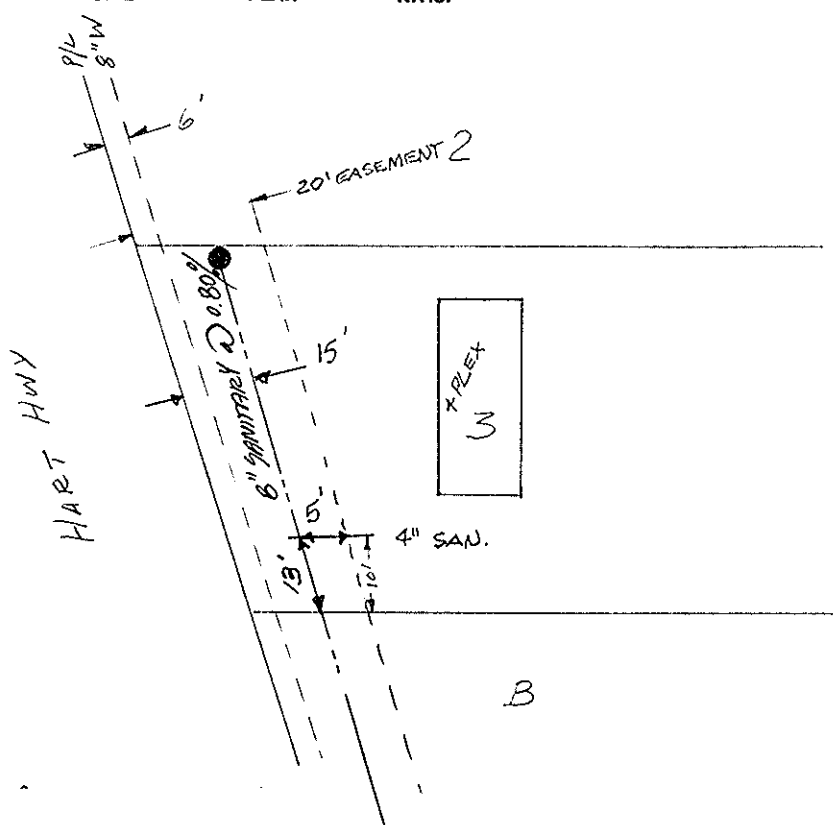

B