

**City of Prince George
HISTORY SHEET**

005813531

05

SHEET NUMBER 10547

Roll Number

Legal: LOT'S B BLOCK _____ D.L. 2423 PLAN 28750

Address: 8597 MCGUIRE RD

Sanitary Connection: # _____ SIZE _____ MATERIAL _____ INV. _____ CONNECTED _____

Water Connection # _____ SIZE _____ MATERIAL _____ METER _____ CONNECTED _____

Storm Connection: # _____ SIZE _____ MATERIAL _____ INV. _____ CONNECTED _____

Cash Receipt No's: WATER _____ SANITARY _____ STORM _____

CURB FROM PROPERTY LINE _____ PAVEMENT WIDTH _____

B.C. HYDRO _____ UNDERGROUND CONNECTION _____


B.C. TELEPHONE _____ UNDERGROUND CONNECTION _____

INLAND GAS As shown

Information Sheets:

Comments:

SITE PLAN N.T.S.

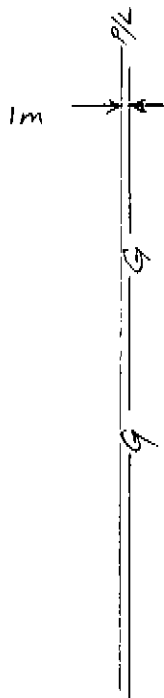

McGuire Rd.

