

City of Prince George HISTORY SHEET

SHEET NUMBER

Roll Number 005846269

Legal: LOT'S 32 BLOCK D.L. 2003 PLAN 28774

Address: 2967 Sullivan Cres

Sanitary Connection: # SIZE 100mm MATERIAL INV. CONNECTED

Water Connection # SIZE 18mm MATERIAL METER CONNECTED

Storm Connection: # SIZE 100mm MATERIAL INV. CONNECTED

Cash Receipt No's: WATER SANITARY STORM

CURB FROM PROPERTY LINE 5m PAVEMENT WIDTH 10m

B.C. HYDRO U/G UNDERGROUND CONNECTION


B.C. TELEPHONE U/G UNDERGROUND CONNECTION

INLAND GAS

Information Sheets: Eng Dwg #3099 + 3245-66

Comments: THE INFORMATION CONTAINED HEREIN IS FOR INTERNAL USE ONLY. NOT TO BE RELIED UPON UNLESS CONFIRMED BY SITE INSPECTION AND/OR INVESTIGATION.

SITE PLAN N.T.S.

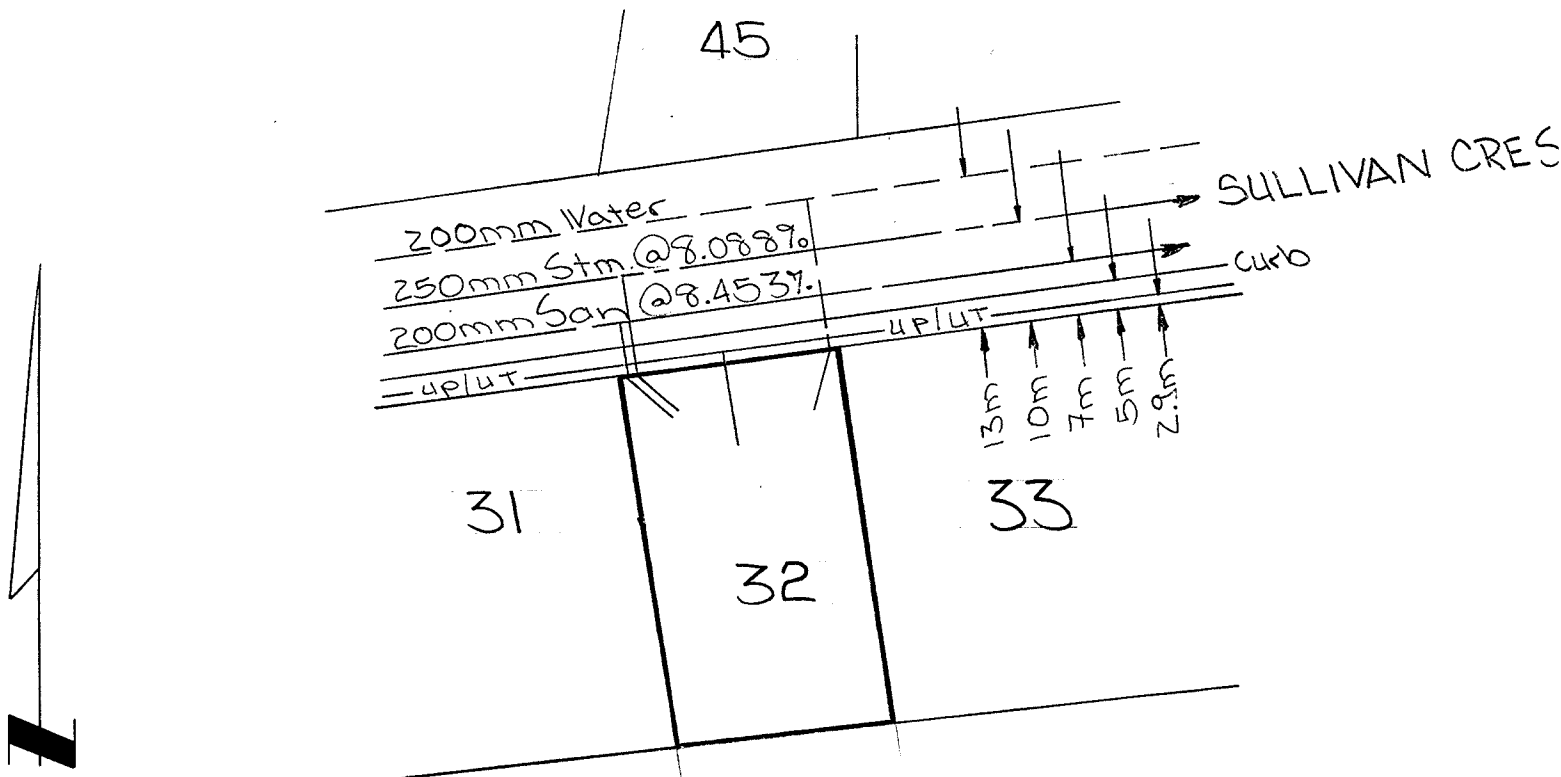

32: 2907
005846 207
57

REPORT TO RECORDS

7.

WATER SERVICE INFORMATION

Lot No. 34 Block _____ D.L. _____

Address 7.
2967 SULLIVAN.


Size of Connection 1/2" 3/4" Other _____

Type of Connection Copper Iron PLASTIC.

Thaw Wire Yes No

LOCATION SKETCH

SULLIVAN

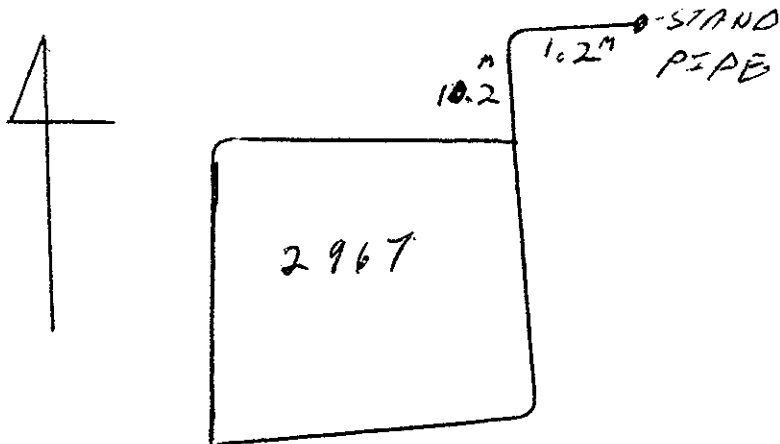

Field Location By Alan Mc Coy Date FEB 14 1984

Checked by: _____

REPORT TO RECORDS

SEWER SERVICE INFORMATION

Lot No. 34 Block _____ D.L. _____

Address 2967 SULLIVAN


Size of Connection 100mm 150mm 200mm Other _____

Type of Connection Transite PVC Other _____

Type of Cap Transite Cast Iron

LOCATION SKETCH

SULLIVAN

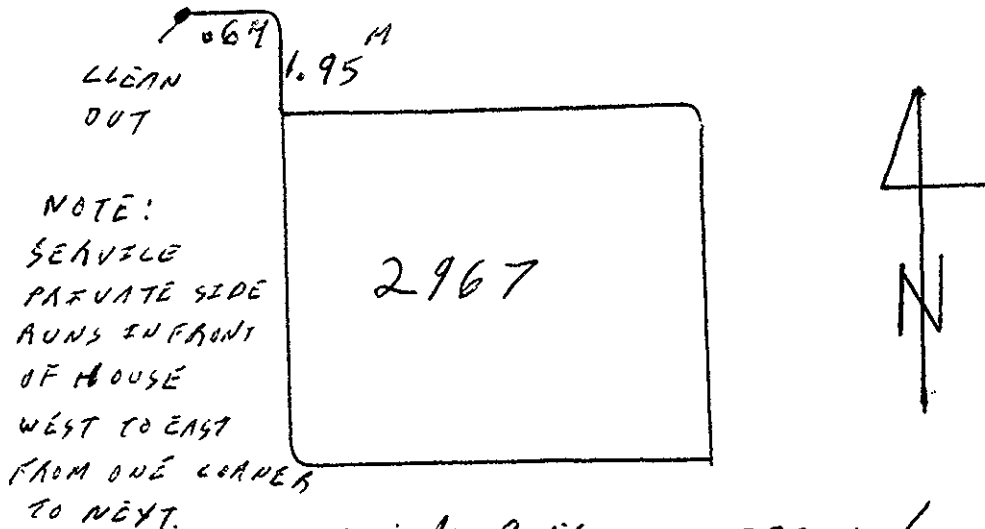

NOTE:
SEWER
PRIVATE SIDE
RUNS IN FRONT
OF HOUSE
WEST TO EAST
FROM ONE CORNER
TO NEXT.

Field Location By Alvin St. Clair Date FEB 14/94

Checked by Foreman - Sewer Division _____