

# City of Prince George HISTORY SHEET

SHEET NUMBER

Roll Number 005878393

Legal: LOT'S 81 BLOCK D.L. 2003 PLAN 28774

Address: 4345 Foster Rd.

Sanitary Connection: # SIZE 100mm MATERIAL INV. CONNECTED

Water Connection # SIZE 19mm MATERIAL METER CONNECTED

Storm Connection: # SIZE MATERIAL INV. CONNECTED

Cash Receipt No's: WATER SANITARY STORM

CURB FROM PROPERTY LINE 5m PAVEMENT WIDTH 10m


B.C. HYDRO U/G UNDERGROUND CONNECTION

B.C. TELEPHONE U/G UNDERGROUND CONNECTION

INLAND GAS


Information Sheets: Eng. Dwg # 3099 + 3245 - 66

Comments: **THE INFORMATION CONTAINED HEREIN IS FOR INTERNAL USE ONLY. NOT TO BE RELIED UPON UNLESS CONFIRMED BY SITE INSPECTION AND/OR INVESTIGATION.**

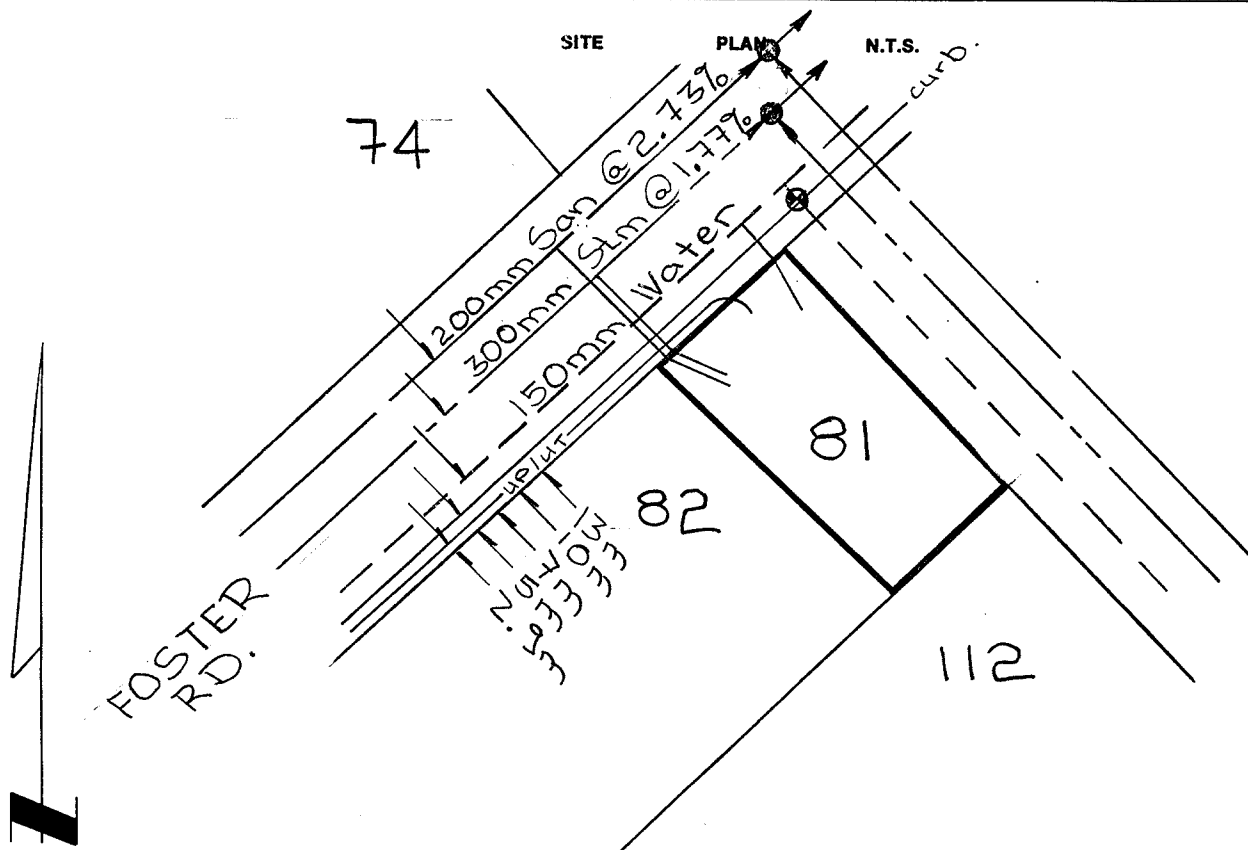

**REPORT TO RECORDS****WATER SERVICE INFORMATION**

Lot No. \_\_\_\_\_ Block \_\_\_\_\_ D.L. \_\_\_\_\_

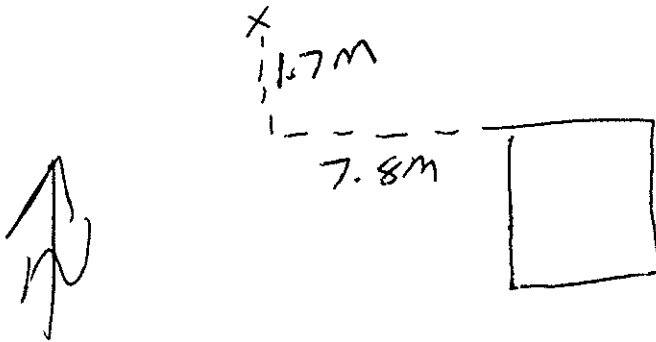Address 4345 Foster RDSize of Connection  1/2"  3/4"  Other \_\_\_\_\_Type of Connection  Copper  IronThaw Wire  Yes  No**LOCATION SKETCH**Field Location By [Signature] Date June 24 1973

Checked by: \_\_\_\_\_

# REPORT TO RECORDS

## SEWER SERVICE INFORMATION

Lot No. \_\_\_\_\_ Block \_\_\_\_\_ D.L. \_\_\_\_\_


Address 4345 Foster RD

Size of Connection  100mm  150mm  200mm  Other \_\_\_\_\_

Type of Connection  Transite  PVC  Other \_\_\_\_\_

Type of Cap  Transite  Cast Iron

### LOCATION SKETCH

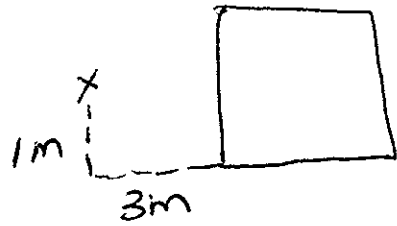

Field Location By JH Date June 24 1973

Checked by Foreman - Sewer Division \_\_\_\_\_