

City of Prince George HISTORY SHEET

SHEET NUMBER

Roll Number 00-5898038

Legal: LOT'S 86 BLOCK _____ D.L. 2003 PLAN 28774

Address: 4371 Foster Rd.

Sanitary Connection: # _____ SIZE 100mm MATERIAL _____ INV. _____ CONNECTED _____

Water Connection # _____ SIZE 19mm MATERIAL _____ METER _____ CONNECTED _____

Storm Connection: # _____ SIZE _____ MATERIAL _____ INV. _____ CONNECTED _____

Cash Receipt No's: WATER _____ SANITARY _____ STORM _____

CURB FROM PROPERTY LINE 5m PAVEMENT WIDTH 10m

B.C. HYDRO U/G UNDERGROUND CONNECTION _____


B.C. TELEPHONE U/G UNDERGROUND CONNECTION _____

INLAND GAS _____

Information Sheets: Eng. Dwg. #3099-3245-66

Comments: _____

SITE PLAN N.T.S.

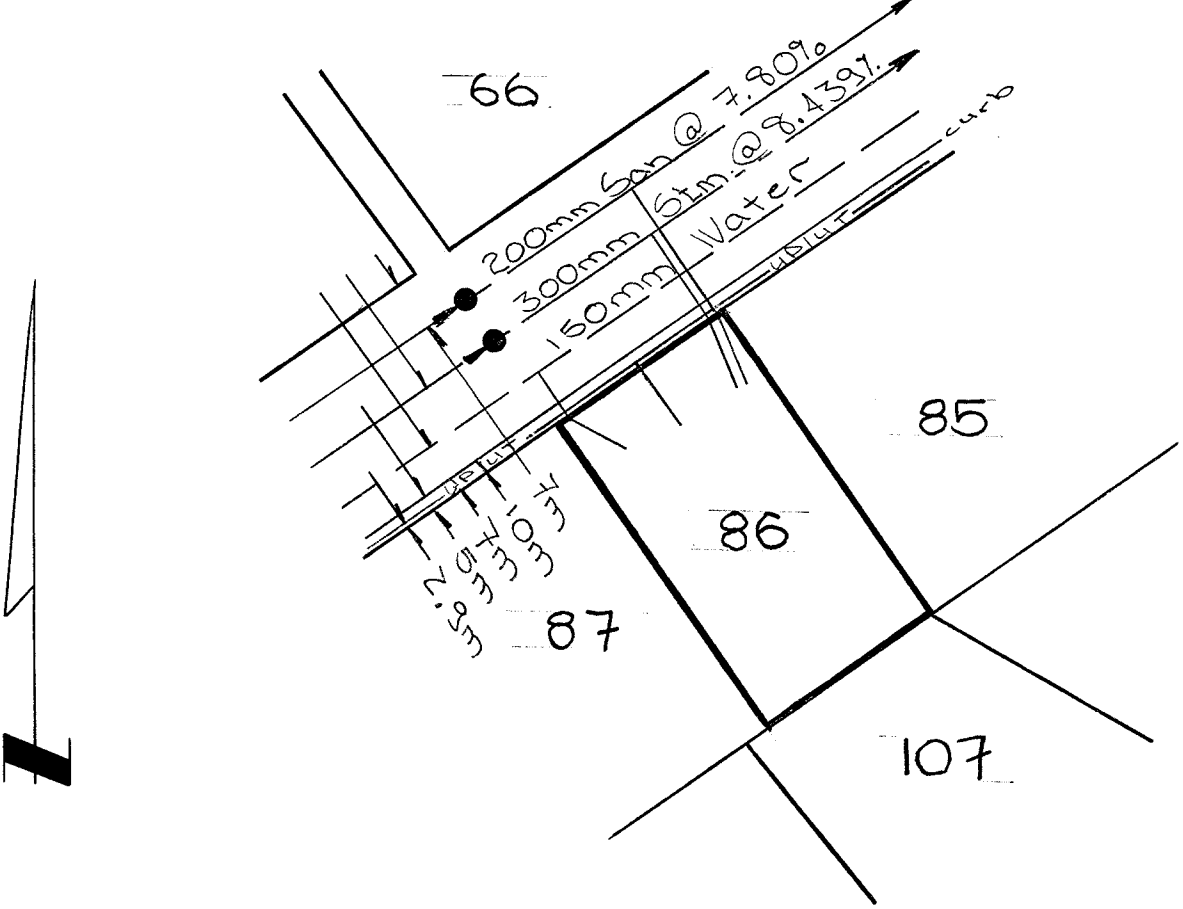

005848628

REPORT TO RECORDS

WATER SERVICE INFORMATION

Lot No. 86/2003/28774 Block _____ D.L. _____


Address 4371 FOSTER

Size of Connection 1/2" 3/4" Other _____

Type of Connection Copper Iron

Thaw Wire Yes No

LOCATION SKETCH

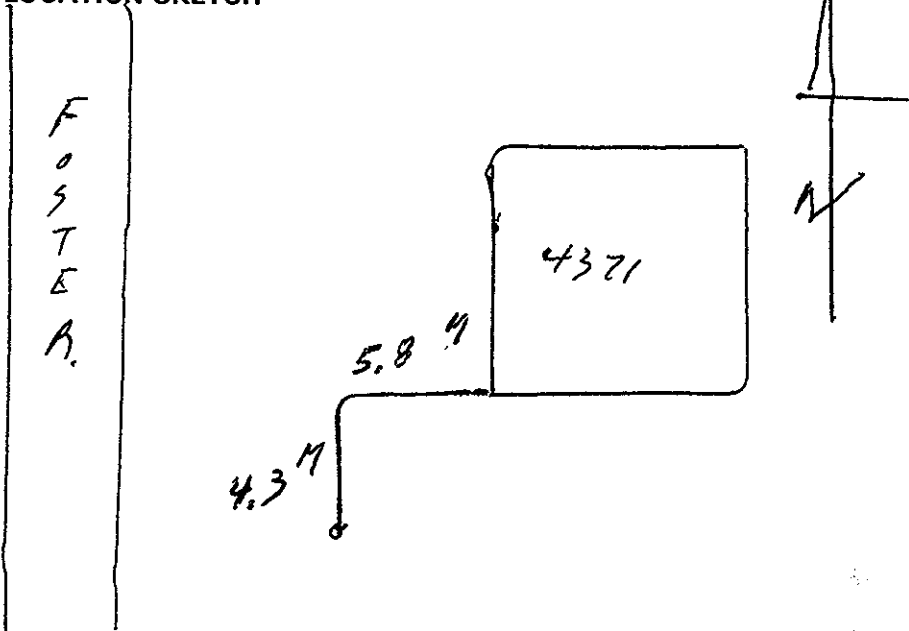

Field Location By A. Lami Sr. Corp Date JULY 20/99.

Checked by: _____

REPORT TO RECORDS

SEWER SERVICE INFORMATION

86/2003/28774

Lot No. _____ Block _____ D.L. _____


Address 4371 FOSTER

Size of Connection 100mm 150mm 200mm Other _____

Type of Connection Transite PVC Other _____

Type of Cap Transite Cast Iron

LOCATION SKETCH

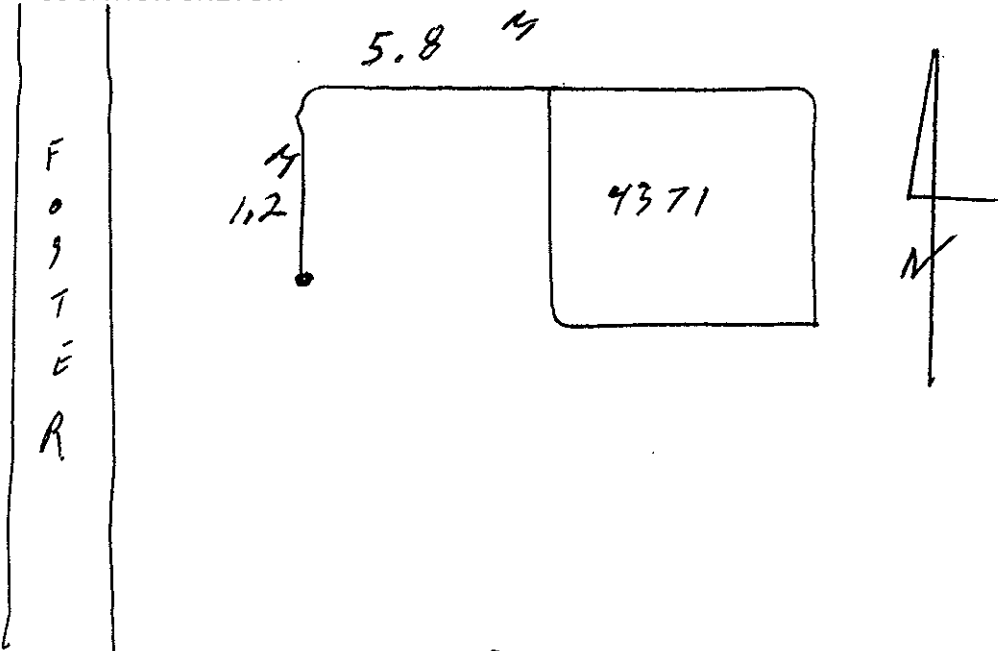

Field Location By A. L. Smith Date JULY 20 1993

Checked by Foreman - Sewer Division _____