

City of Prince George HISTORY SHEET

SHEET NUMBER

Roll Number 005819/28

Legal: LOT'S 96 BLOCK D.L. 2003 PLAN 28774

Address: 4426 WHEELER Rd

Sanitary Connection: # SIZE 100mm MATERIAL INV. CONNECTED

Water Connection # SIZE 19mm MATERIAL METER CONNECTED

Storm Connection: # SIZE MATERIAL INV. CONNECTED

Cash Receipt No's: WATER SANITARY STORM

CURB FROM PROPERTY LINE 5m PAVEMENT WIDTH 10m

B.C. HYDRO UIG UNDERGROUND CONNECTION

B.C. TELEPHONE UIG UNDERGROUND CONNECTION



INLAND GAS

Information Sheets: Eng Divg. 3092-3245-66

Comments: SEWER LOCATION NOT CONFIRMED

**THE INFORMATION CONTAINED HEREIN IS FOR INTERNAL
USE ONLY NOT TO BE RELIED UPON UNLESS CONFIRMED
BY SITE INSPECTION AND/OR INVESTIGATION.**

SITE PLAN N.T.S.

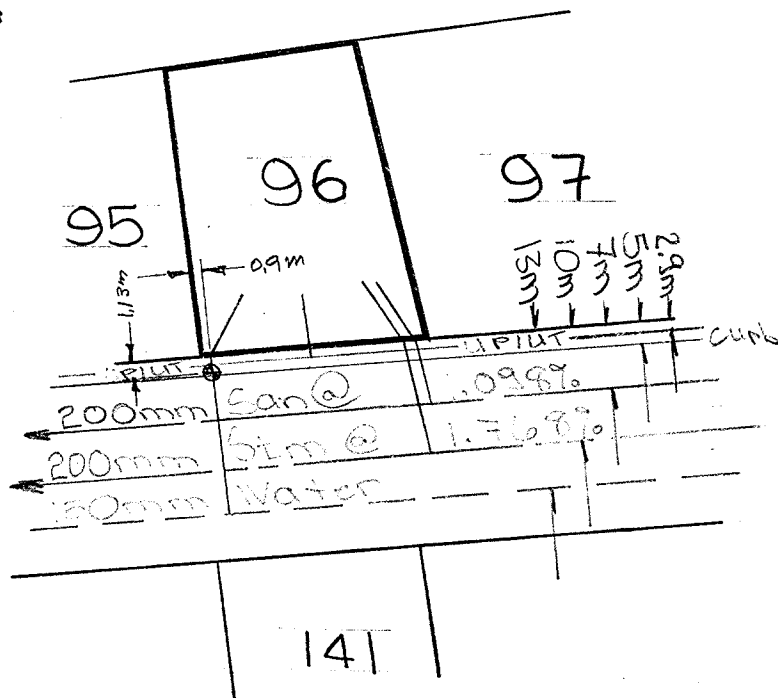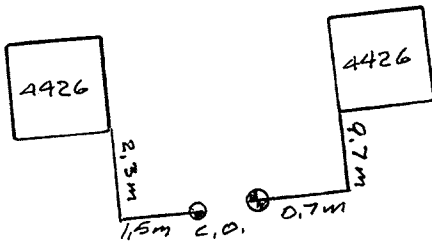

WHEELER RD

141