

City of Prince George HISTORY SHEET

SHEET NUMBER

Roll Number 005849179

Legal: LOT'S 97 BLOCK D.L. 2003 PLAN 28774

Address: 4430 WHEELER Rd.

Sanitary Connection: # SIZE 100mm MATERIAL INV. CONNECTED

Water Connection # SIZE 19mm MATERIAL METER CONNECTED

Storm Connection: # SIZE 100mm MATERIAL INV. CONNECTED

Cash Receipt No's: WATER SANITARY STORM

CURB FROM PROPERTY LINE 5m PAVEMENT WIDTH 10m

B.C. HYDRO U/G UNDERGROUND CONNECTION

B.C. TELEPHONE U/G UNDERGROUND CONNECTION


INLAND GAS

Information Sheets: Eng. Dwg. #3099 + 3245-66

Comments: SAN + STORM LOCATION NOT CONFIRMED

THE INFORMATION CONTAINED HEREIN IS FOR INTERNAL
USE ONLY. NOT TO BE RELIED UPON UNLESS CONFIRMED
BY SITE INSPECTION AND/OR INVESTIGATION.

SITE PLAN N.T.S.

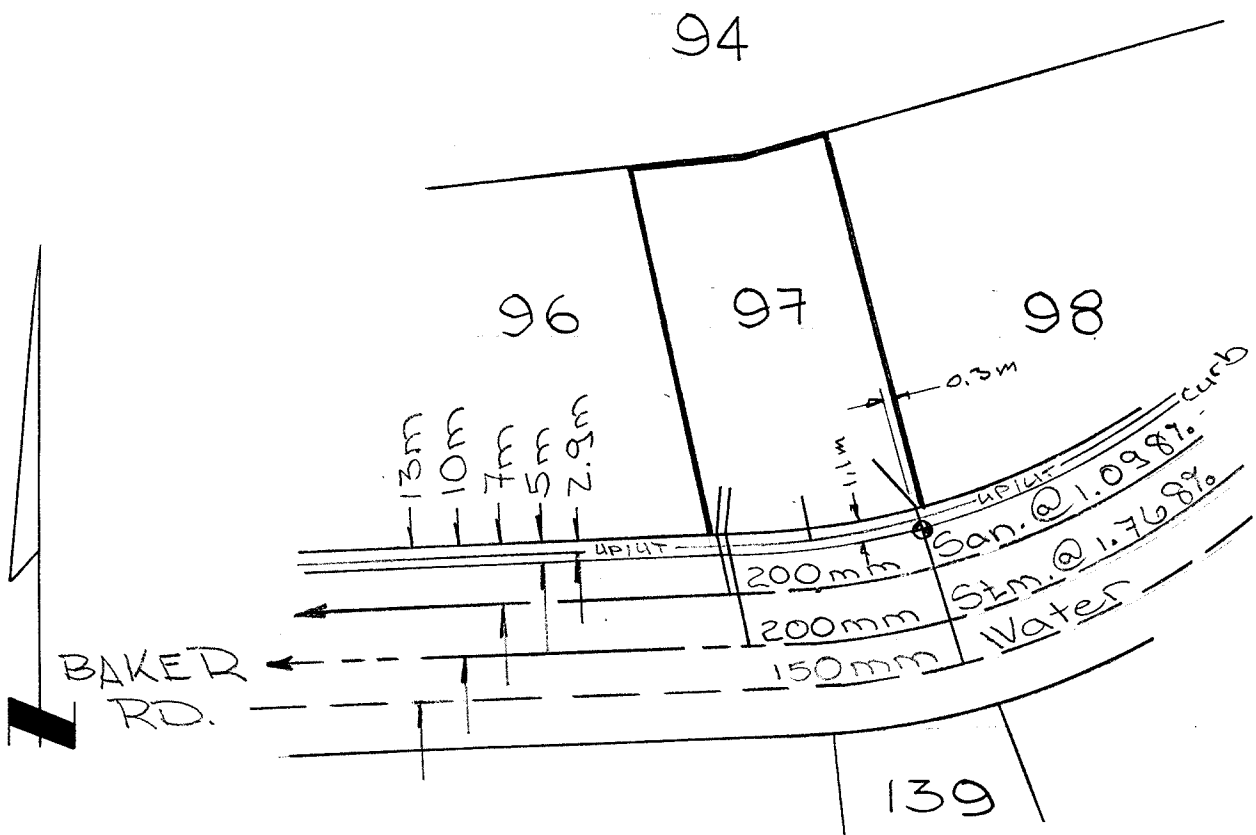

005849179

REPORT TO RECORDS

WATER SERVICE INFORMATION

Lot No. 97/203/28774 Block 28774 D.L. _____


Address 4430 WHEELER.

Size of Connection 1/2" 3/4" Other _____

Type of Connection Copper Iron

Thaw Wire Yes No

LOCATION SKETCH

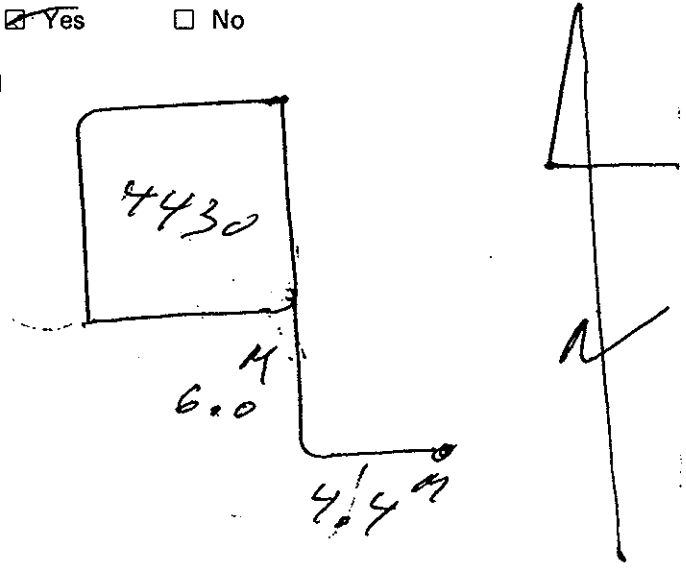

WHEELER

Field Location By Alvin J. Coff Date JUNE 22/95

Checked by: _____

REPORT TO RECORDS

SEWER SERVICE INFORMATION

97/2003/28774

Lot No. _____ Block _____ D.L. _____


Address 4430 WHEELER.

Size of Connection 100mm 150mm 200mm Other _____

Type of Connection Transite PVC Other _____

Type of Cap Transite Cast Iron

LOCATION SKETCH

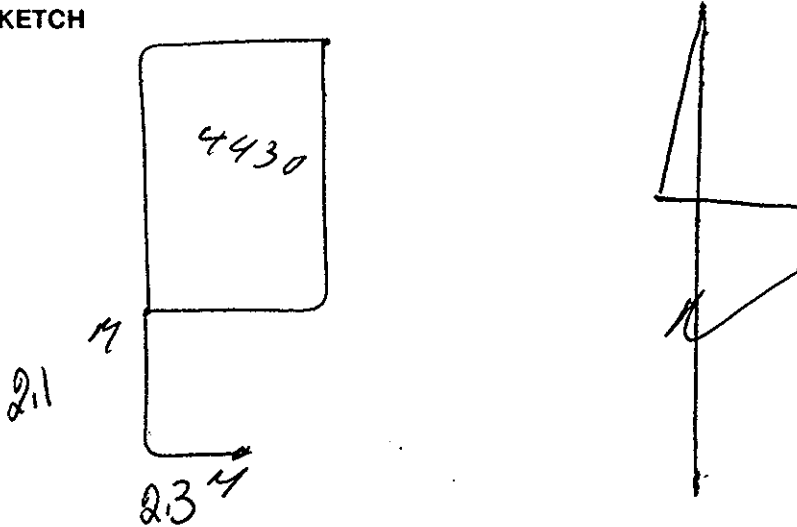

WHEELER

Field Location By Alvin St. Clair Date JUNE 22/95.

Checked by Foreman - Sewer Division _____