

**City of Prince George
HISTORY SHEET**

5

SHEET NUMBER

Roll Number

105840351

Legal: LOT'S 109

BLOCK

D.L. 2003

PLAN

28774

Address: 2750 Bell Place

Sanitary Connection: #

SIZE 100mm MATERIAL P.V.C. INV.

CONNECTED

Water Connection #

SIZE 20mm MATERIAL CU METER

CONNECTED

Storm Connection: #

SIZE 100mm MATERIAL P.V.C. INV.

CONNECTED

Cash Receipt No's:

WATER

SANITARY

STORM

CURB FROM PROPERTY LINE 5m

PAVEMENT WIDTH 10mm

B.C. HYDRO

U/G

UNDERGROUND CONNECTION

B.C. TELEPHONE

U/G

UNDERGROUND CONNECTION

INLAND GAS



Information Sheets:

Eng Dwg # 3099

Comments:

THE INFORMATION CONTAINED HEREIN IS FOR INTERNAL
USE ONLY. NOT TO BE RELIED UPON UNLESS CONFIRMED
BY SITE INSPECTION AND/OR INVESTIGATION.

SITE PLAN N.T.S.

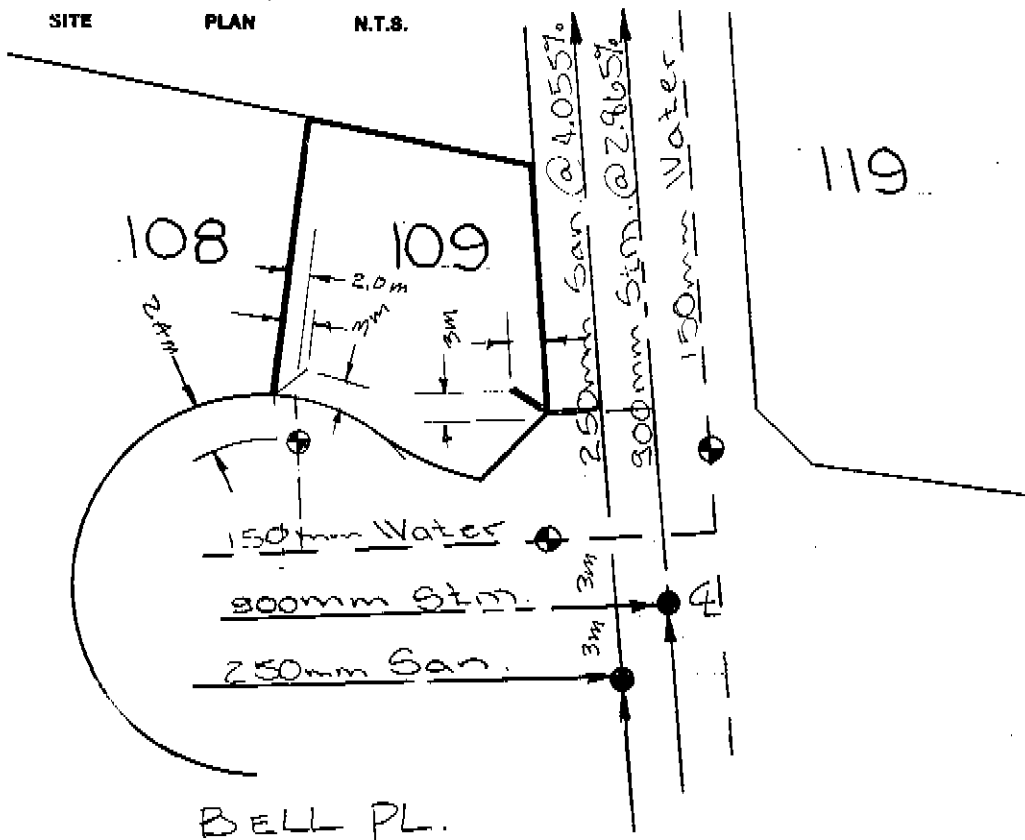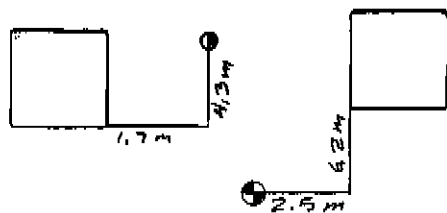

119

BELL PL.