

# City of Prince George HISTORY SHEET

SHEET NUMBER

Roll Number 005850096

Legal: LOT'S 130

BLOCK

D.L. 2003

PLAN

28774

Address: 2682 Hewlett Crt.

Sanitary Connection: # SIZE 100 mm MATERIAL P.V.C. INV. CONNECTED

Water Connection # SIZE 20 mm MATERIAL CU. METER CONNECTED

Storm Connection: # SIZE 100 mm MATERIAL P.V.C. INV. CONNECTED

Cash Receipt No's: WATER SANITARY STORM

CURB FROM PROPERTY LINE 5m. PAVEMENT WIDTH

B.C. HYDRO U/G UNDERGROUND CONNECTION


B.C. TELEPHONE U/G UNDERGROUND CONNECTION

INLAND GAS

Information Sheets: Eng Dwg # 3099

Comments:

THE INFORMATION CONTAINED HEREIN IS FOR INTERNAL  
USE ONLY. NOT TO BE RELIED UPON UNLESS CONFIRMED  
BY SITE INSPECTION AND/OR INVESTIGATION

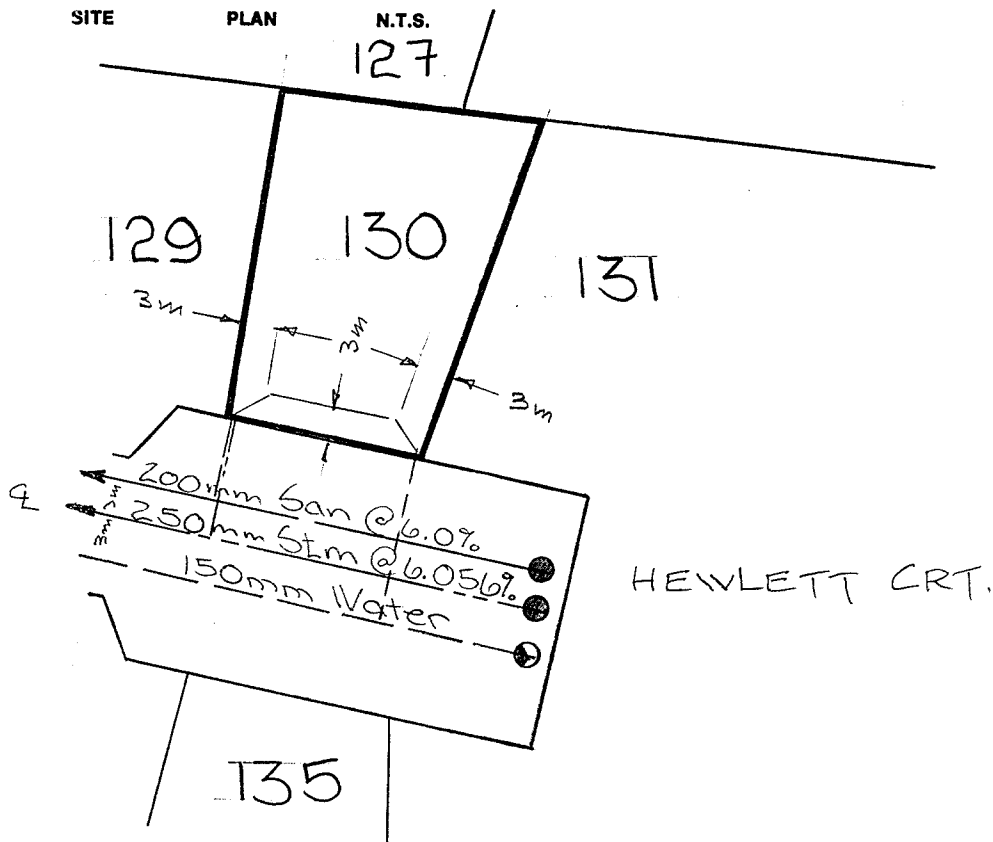

# REPORT TO RECORDS

## WATER SERVICE INFORMATION

Lot No. \_\_\_\_\_ Block \_\_\_\_\_ D.L. \_\_\_\_\_


Address 2682 HEWELLETT COURT.

Size of Connection  1/2"  3/4"  Other \_\_\_\_\_

Type of Connection  Copper  Iron

Thaw Wire  Yes  No

### LOCATION SKETCH

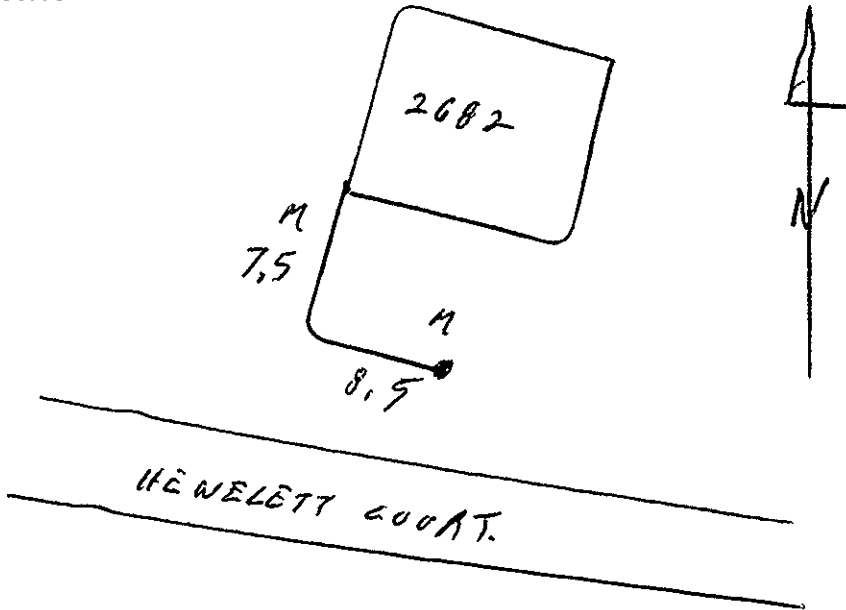


Field Location By A. Lavin, Jr. CW4 Date MARCH 26/96.

Checked by: \_\_\_\_\_

**REPORT TO RECORDS**

## SEWER SERVICE INFORMATION

Lot No. \_\_\_\_\_ Block \_\_\_\_\_ D.L. \_\_\_\_\_

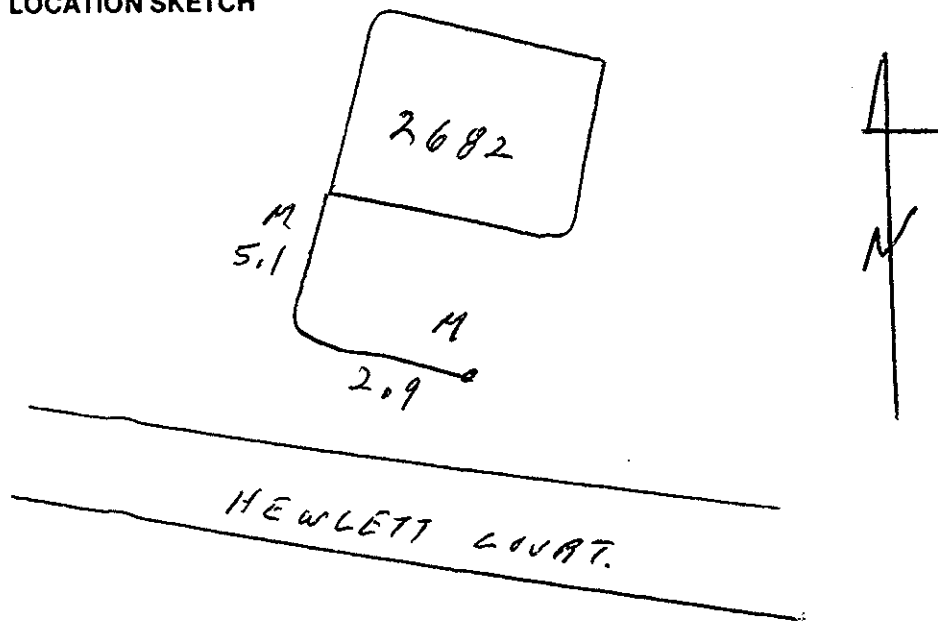Address 2682 HEWLETT COURT.Size of Connection  100mm  150mm  200mm  Other \_\_\_\_\_Type of Connection  Transite  PVC  Other \_\_\_\_\_Type of Cap  Transite  Cast Iron**LOCATION SKETCH**Field Location By Adrian P. Croft Date MARCH 26/96.

Checked by Foreman - Sewer Division \_\_\_\_\_