

City of Prince George HISTORY SHEET

SHEET NUMBER **Nº 1620** Roll Number **005894450**

Legal: LOT'S **A** BLOCK **D.L. 2507** PLAN **28656**

Address: **4066 RAINBOW DR**

Sanitary Connection: # SIZE **200** MATERIAL INV. CONNECTED

Water Connection # SIZE **200** MATERIAL METER CONNECTED

Storm Connection: # **1439** SIZE **375**
200 MATERIAL **PVC** INV. CONNECTED

Cash Receipt No's: WATER **MU100004** SANITARY **MU100004** STORM **991/MU100004**

CURB FROM PROPERTY LINE PAVEMENT WIDTH


B.C. HYDRO UNDERGROUND CONNECTION

B.C. TELEPHONE UNDERGROUND CONNECTION

INLAND GAS

Information Sheets: THE INFORMATION CONTAINED HEREIN IS FOR INTERNAL USE ONLY. NOT TO BE RELIED UPON UNLESS CONFIRMED BY SITE INSPECTION AND/OR INVESTIGATION.


Comments:

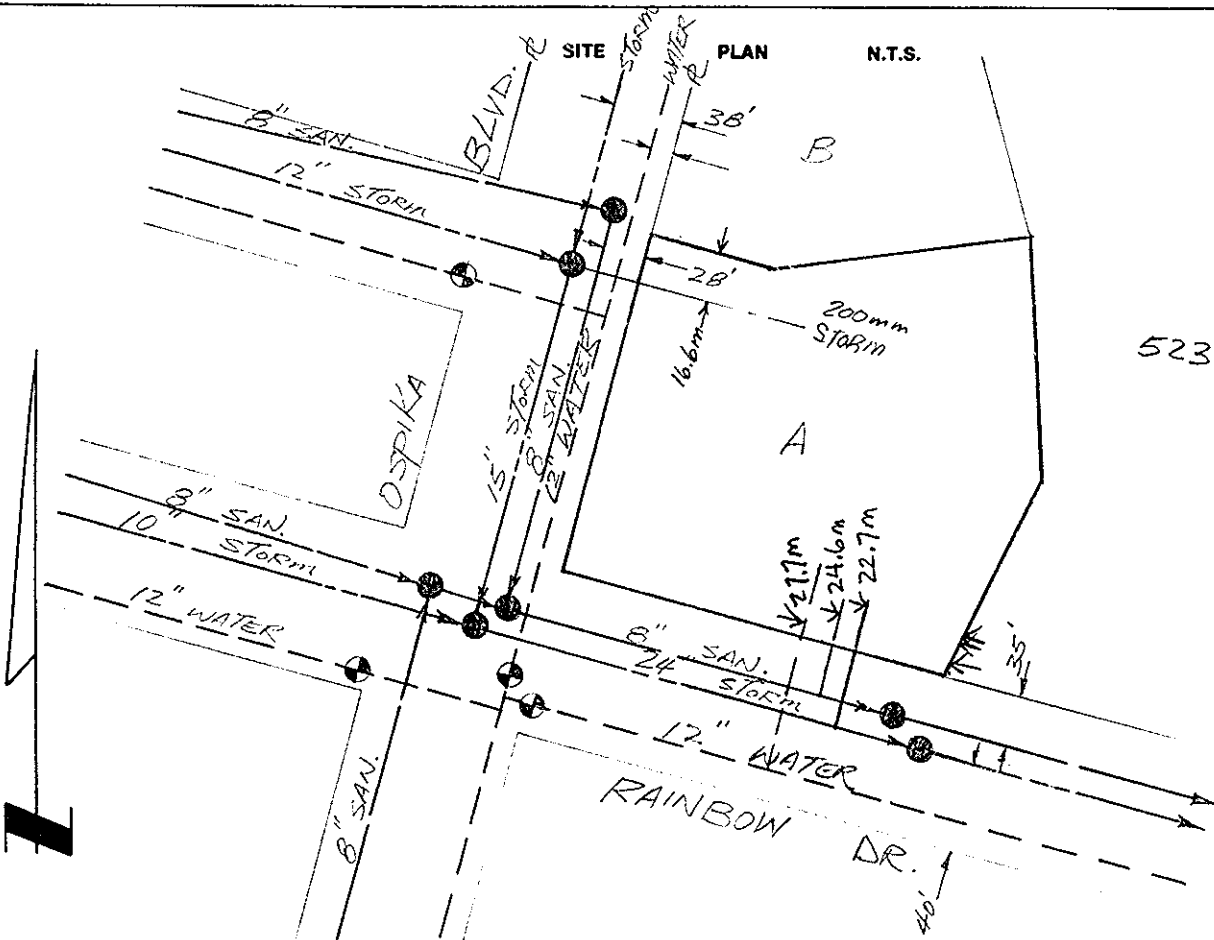

4066 Rainbow Drive
(Rainbow Village)

20: 11:11 21:11
375 512M.

005894450

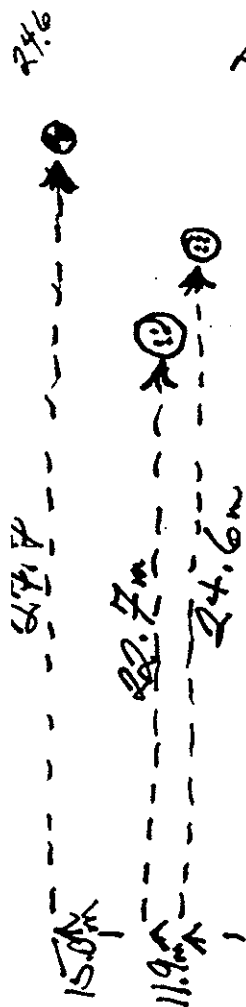

Water location: From the south-east corner of the lot 15.0m south and 27.7m west.

Storm location: From the south-east corner of the lot 11.9m south and 22.7m west.

Sanitary location: From the south-east corner of the lot 10.0m south and 24.6m west.

→ NORTH