


22 040 001

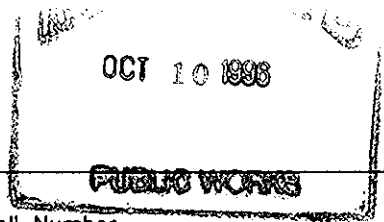

City of Prince George HISTORY SHEET

SHEET NUMBER

Roll Number

Legal: LOT'S A BLOCK D.L. 4039 PLAN 28628 C.D.

Address: MONTEREY ROAD

Sanitary Connection: SIZE 150mm MATERIAL PVC INV. 692.59 CONNECTED Y

Water Connection: SIZE 50mm MATERIAL CU METER N CONNECTED Y

Storm Connection: SIZE 200mm MATERIAL CSP INV. 693.16 CONNECTED Y

Cash Receipt No's: WATER SANITARY STORM

CURB FROM PROPERTY LINE 6.0 m PAVEMENT WIDTH 13.0 m

B.C. HYDRO O.H. UNDERGROUND CONNECTION

B.C. TELEPHONE O.H. UNDERGROUND CONNECTION

INLAND GAS U.G.

Information Sheets:

Comments:

THE INFORMATION CONTAINED HEREIN IS FOR INTERNAL USE ONLY.
NOT TO BE RELIED UPON UNLESS CONFIRMED BY SITE INSPECTION AND/OR INVESTIGATION

