



City of Prince George
History Sheet

PID:	005960479
MU:	101678
WO:	88412

Civic Address: 1702 Lyon St

Legal Description: Lot: 2 District Lot: 936 Plan: 28440


Service Type	Diameter (mm)	Material	Invert Elev at main (m)	Invert Elev at property line (m)	Invert Depth at service end (m)	Distance into property (m)	Installation Date
Sanitary	100mm	AC	-	-	2.74	-	June 1976
Water	25mm	Copper	-	-	-	-	October 1961
Storm	200mm	PVC	-	-	-	-	June 2016

Service Connection Location				Sanitary (m)	Storm (m)
Distance from downstream San MH	3140	towards upstream San MH	850	16.41	
200mm Storm service connected to Stm MH 2414					

Power	Size	Communications	Size	Cable	Size	Gas	Size
BC Hydro	-	Telus	-	Shaw	-	FortisBC	-
Overhead Service		Overhead Service		Overhead Service			

Installed by:	City of Prince George forces	Survey Date:	-
Comments:			

NOT TO SCALE The information contained herein is for internal use only.
Not to be relied on unless confirmed by site inspection and/or investigation.

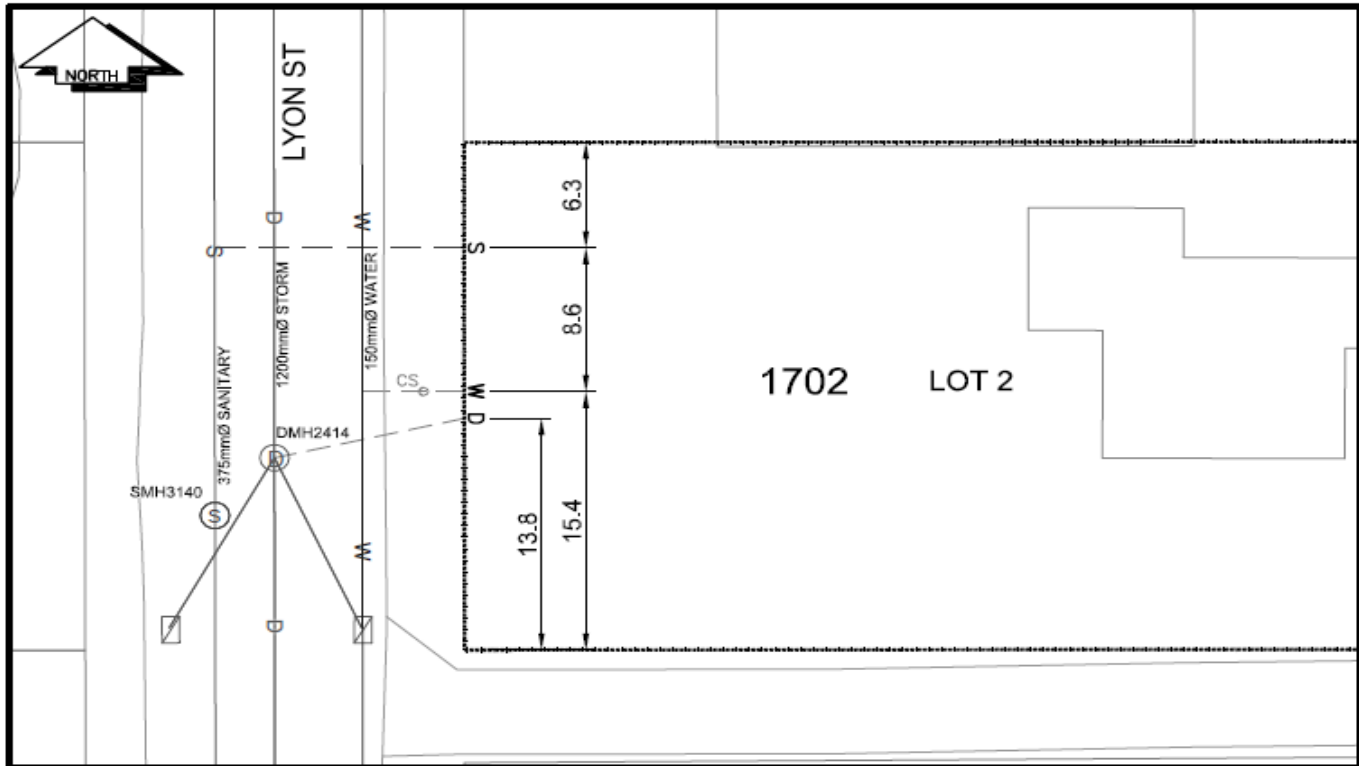

LEGEND:

CS ⁰	CURB STOP	---	W	WATER SERVICE	---	D	STORM SERVICE
CO ⁰	CLEAN OUT	---	S	SANITARY SERVICE	---	G	GAS

NOT TO SCALE