

**City of Prince George
HISTORY SHEET**

005977061

SHEET NUMBER

Roll Number

Legal: LOT'S A BLOCK _____ D.L. 932 PLAN 29584

Address: 1375 STRATHCONA

Sanitary Connection: # 16016 SIZE 100mm MATERIAL PVC INV. 567.188 CONNECTED

Water Connection # 16016 SIZE 20mm MATERIAL Copper METER _____ CONNECTED

Storm Connection: # _____ SIZE _____ MATERIAL _____ INV. _____ CONNECTED

Cash Receipt No's: WATER 571 SANITARY 572 STORM _____

CURB FROM PROPERTY LINE _____ PAVEMENT WIDTH _____


B.C. HYDRO _____ UNDERGROUND CONNECTION _____

B.C. TELEPHONE _____ UNDERGROUND CONNECTION _____

INLAND GAS _____

Information Sheets: _____

Comments: _____

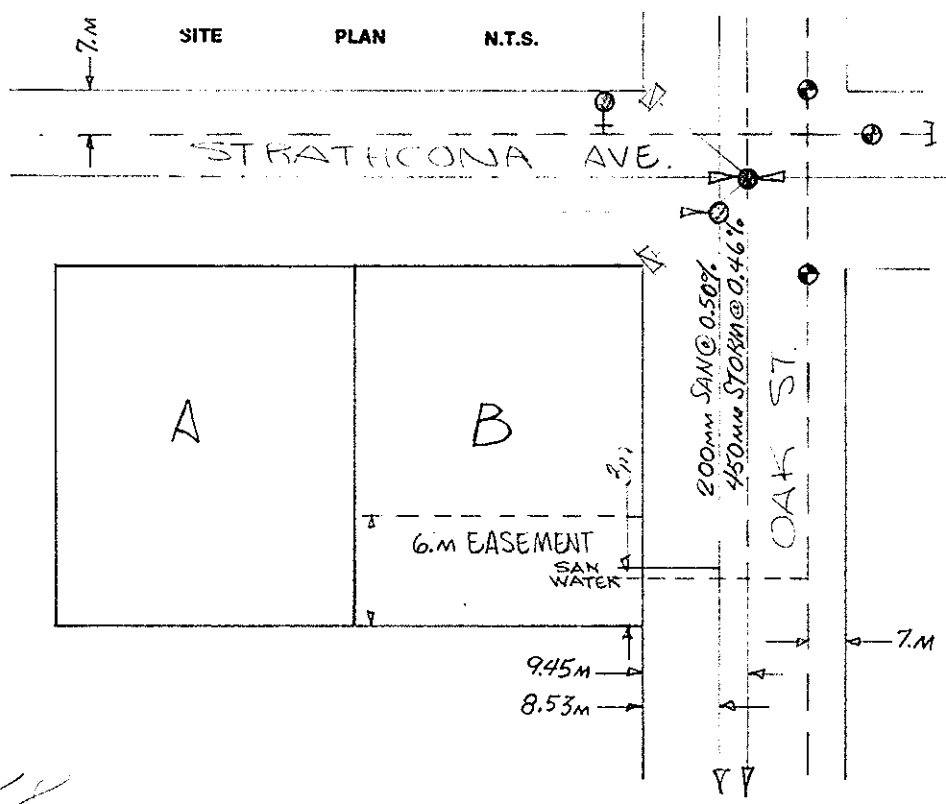

14