


Lot Servicing

2731 MERRITT RD

PID: 005996970

Lot: 9, Block: B, Plan: 9266, DL: 8182

SERVICE	SIZE	MATERIAL	INSTALLED DATE	LOCATION	DETAILS
WATER	20MM	CU	01-Jan-1977	No location-bldg demolished 2009	CASH RECEIPT NUMBER 0502
SANITARY	100MM	AC		3.05M W OF E P/L	CONNECTION # 22+9

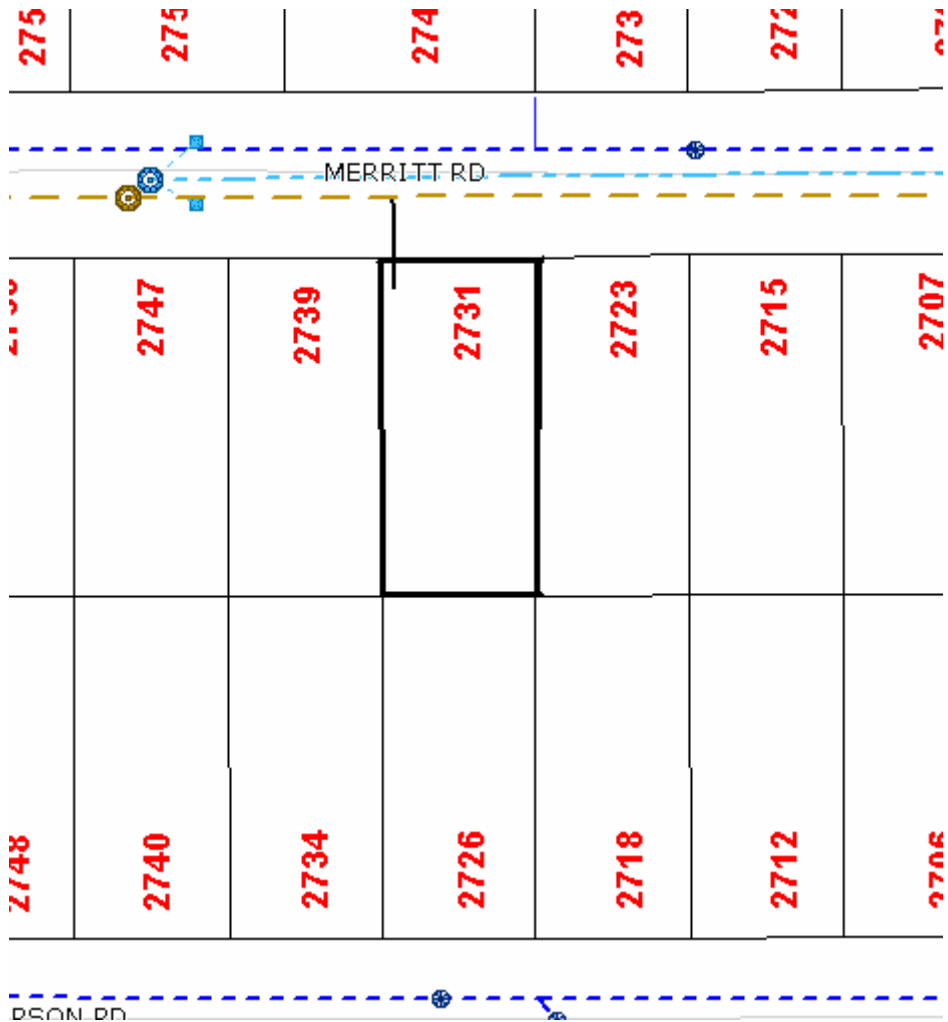

Accuracy not guaranteed unless confirmed by site inspection and/or investigation.
Connection location between main and property line only.