

**City of Prince George  
HISTORY SHEET**

SHEET NUMBER

PID # 006-023-525

**Legal:** LOTS 9 BLOCK 3 D.L. 8178 PLAN 16808

**Address:** 245 LAUREL CRES.

**Sanitary Connection:** # 6229 SIZE 100 mm MATERIAL A.C. INV. 586,985 CONNECTED

**Water Connection:** # 6229 SIZE 20 mm MATERIAL C.U. METER CONNECTED

**Storm Connection:** # SIZE mm MATERIAL INV. CONNECTED

**Cash Receipt No's:** WATER SANITARY STORM

CURB FROM PROPERTY LINE 4.572 m PAVEMENT WIDTH 9.144 m

B.C. HYDRO U/G UNDERGROUND CONNECTION


B.C. TELEPHONE U/G UNDERGROUND CONNECTION

INLAND GAS 3.048 m FROM NORTH SIDE OF LAUREL CRES.

**Information Sheets:**

**Comments:** WITH THAW WIRE.

**THE INFORMATION CONTAINED HEREIN IS FOR INTERNAL USE ONLY.  
NOT TO BE RELIED UPON UNLESS CONFIRMED BY SITE INSPECTION AND/OR INVESTIGATION**

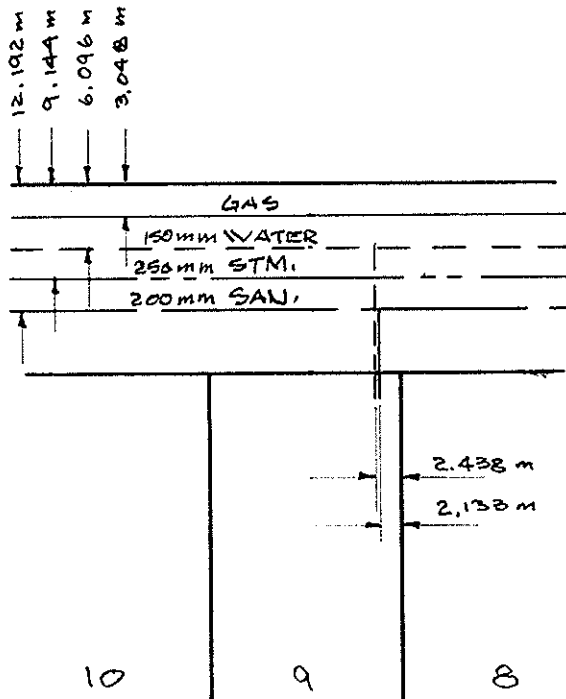

LAUREL CRES.

