

**City of Prince George
HISTORY SHEET**

006012171

SHEET NUMBER **N^o 1874** Roll Number

Legal: LOT'S **A** BLOCK D.L. **343** PLAN **15263**

Address: **1890 SPRUCE STREET**

Sanitary Connection: # **4327** SIZE **6"** MATERIAL **A.C.** INV. CONNECTED

Water Connection # **4108** SIZE **1 1/2"** MATERIAL **COPPER** METER #**125** CONNECTED JULY 15/6

Storm Connection: # SIZE MATERIAL INV. CONNECTED

Cash Receipt No's: WATER SANITARY STORM

CURB FROM PROPERTY LINE PAVEMENT WIDTH

B.C. HYDRO UNDERGROUND CONNECTION

B.C. TELEPHONE UNDERGROUND CONNECTION

INLAND GAS



Information Sheets:

Comments:

SITE

PLAN

N.T.S.

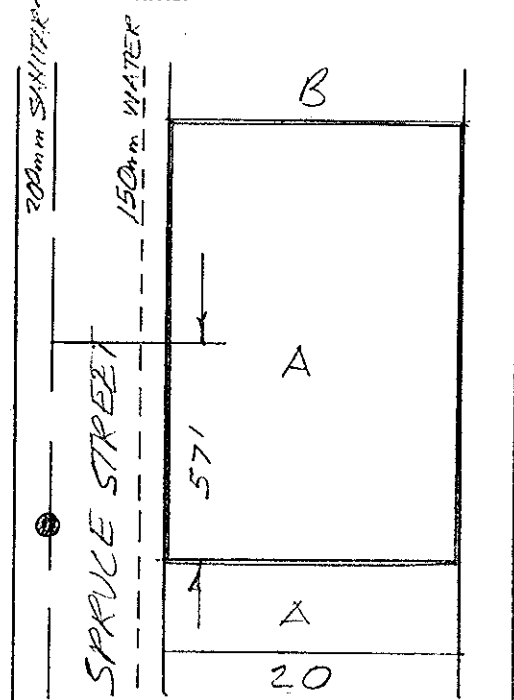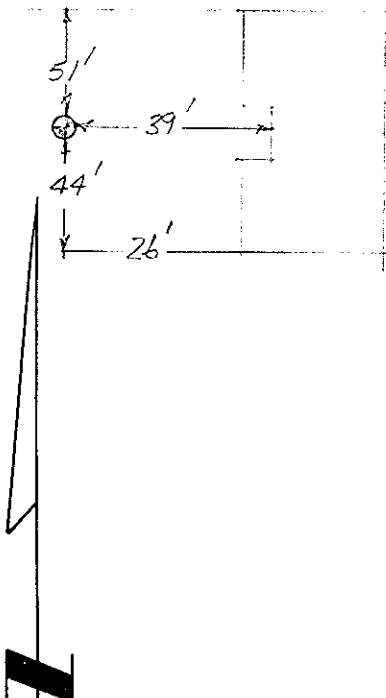

REPORT TO RECORDS

SEWER SERVICE INFORMATION

Lot No. _____ Block _____ D.L. _____


Address 1890 SPRUCE

Size of Connection 100mm 150mm 200mm Other _____

Type of Connection Transite PVC Other _____

Type of Cap Transite Cast Iron

LOCATION SKETCH

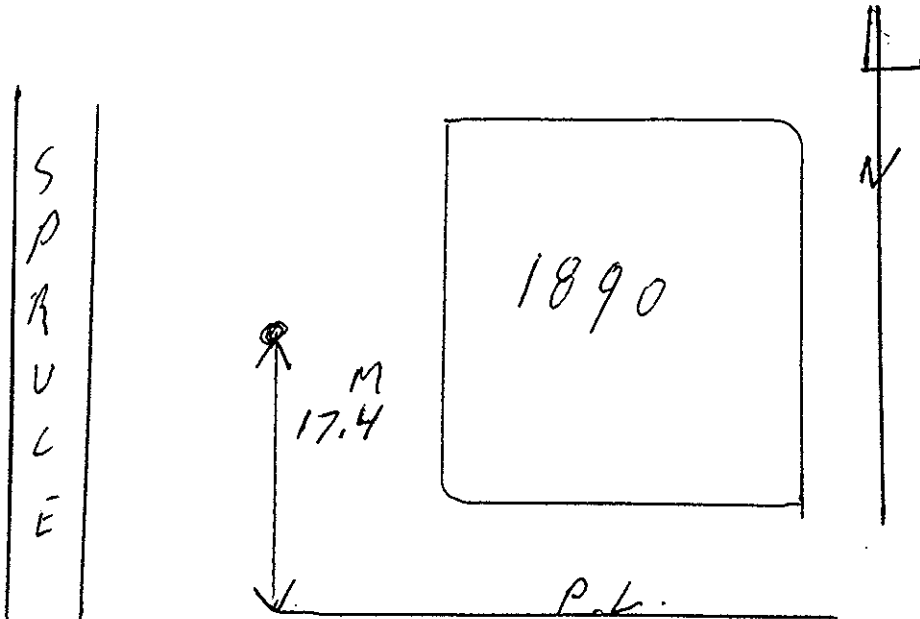

Field Location By A. Samil-Crow Date Nov. 8/02

Checked by Foreman - Sewer Division _____