

City of Prince George HISTORY SHEET

SHEET NUMBER

Roll Number 006073913

Legal: LOT'S A BLOCK _____ D.L. 1544 PLAN 28199

Address: 2980 SOUTH BLACKBURN ROAD

Sanitary Connection: # 11444 SIZE 100mm MATERIAL A.C. INV. _____ CONNECTED _____

Water Connection # 11444 SIZE 20mm MATERIAL C.U. METER _____ CONNECTED _____

Storm Connection: # _____ SIZE _____ MATERIAL _____ INV. _____ CONNECTED _____

Cash Receipt No's: WATER _____ SANITARY _____ STORM _____

CURB FROM PROPERTY LINE _____ PAVEMENT WIDTH _____

B.C. HYDRO _____ UNDERGROUND CONNECTION _____

B.C. TELEPHONE _____ UNDERGROUND CONNECTION _____


INLAND GAS _____

Information Sheets:

Comments:

**THE INFORMATION CONTAINED HEREIN IS FOR INTERNAL
USE ONLY. NOT TO BE RELIED UPON UNLESS CONFIRMED
BY SITE INSPECTION AND/OR INVESTIGATION.**

SITE PLAN N.T.S.

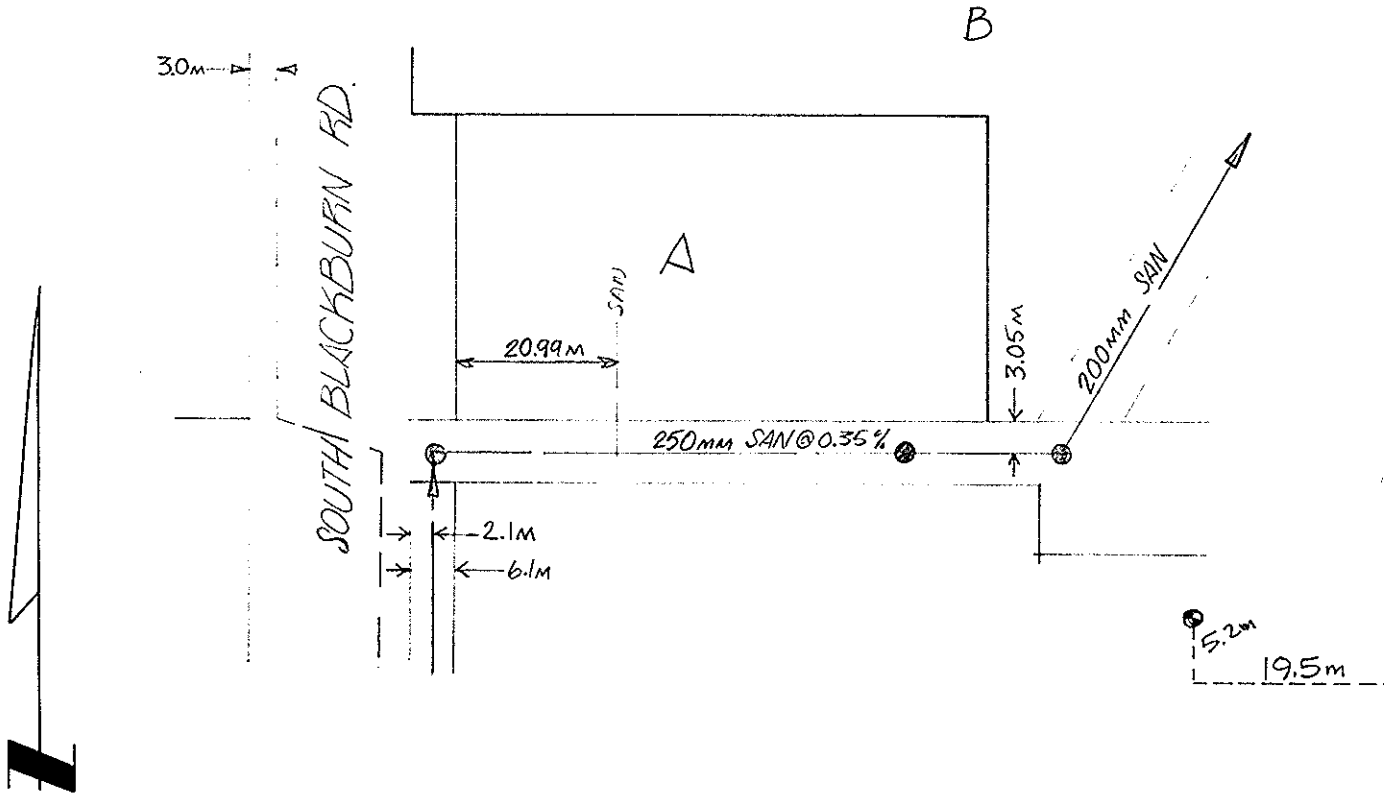

SEE (CITY BOOK 3931-15) FOR OTHER CONNECTIONS.