

**City of Prince George
HISTORY SHEET**

2005/051
640

SHEET NUMBER **N^o 2293** Roll Number

Legal: LOT'S **21-22** BLOCK **6** D.L. **937** PLAN **757**

Address: **770 IRWIN STREET**

Sanitary Connection: # **3413** SIZE MATERIAL INV. **CONNECTED**

Water Connection # **954** SIZE **13mm** MATERIAL METER **CONNECTED**

Storm Connection: # SIZE MATERIAL INV. **CONNECTED**

Cash Receipt No's: WATER SANITARY **1388** STORM

CURB FROM PROPERTY LINE **4.877m** PAVEMENT WIDTH

B.C. HYDRO **OVERHEAD** UNDERGROUND CONNECTION


B.C. TELEPHONE **OVERHEAD** UNDERGROUND CONNECTION

INLAND GAS

Information Sheets:

Comments:

SITE PLAN N.T.S.

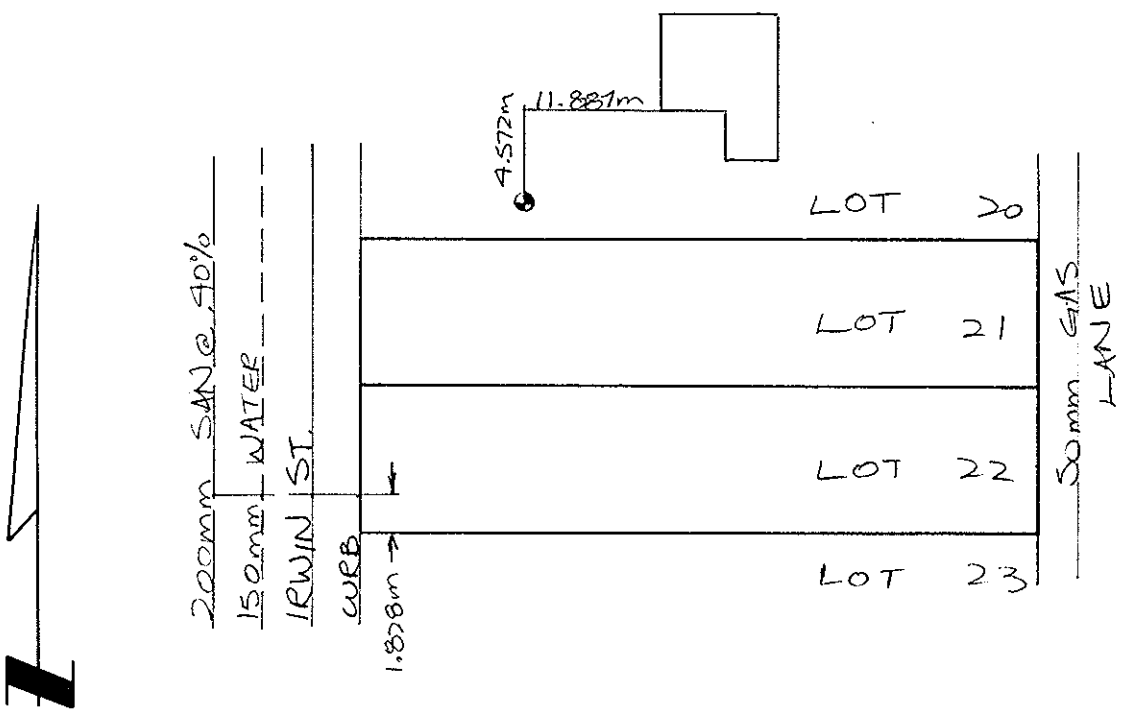

REPORT TO RECORDS

WATER SERVICE INFORMATION

Lot No. _____ Block _____ D.L. _____


Address 770. Irwin

Size of Connection 1/2" 3/4" Other _____

Type of Connection Copper Iron

Thaw Wire Yes No

LOCATION SKETCH

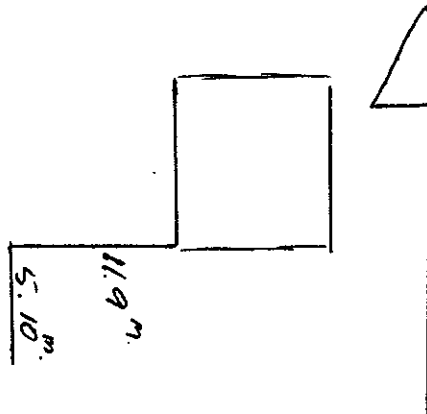

Field Location By R.C Date 6/8/02

Checked by: _____