

2001-001  
640

# City of Prince George HISTORY SHEET

SHEET NUMBER **N<sup>o</sup> 2293** Roll Number

Legal: LOT'S **21-22** BLOCK **6** D.L. **937** PLAN **752**

Address: **770 IRWIN STREET**

Sanitary Connection: # **3413** SIZE MATERIAL INV. CONNECTED

Water Connection # **954** SIZE **13mm** MATERIAL METER CONNECTED

Storm Connection: # SIZE MATERIAL INV. CONNECTED

Cash Receipt No's: WATER SANITARY **1388** STORM

CURB FROM PROPERTY LINE **4.877m** PAVEMENT WIDTH

B.C. HYDRO **OVERHEAD** UNDERGROUND CONNECTION


B.C. TELEPHONE **OVERHEAD** UNDERGROUND CONNECTION

INLAND GAS

Information Sheets:

Comments:

SITE PLAN N.T.S.

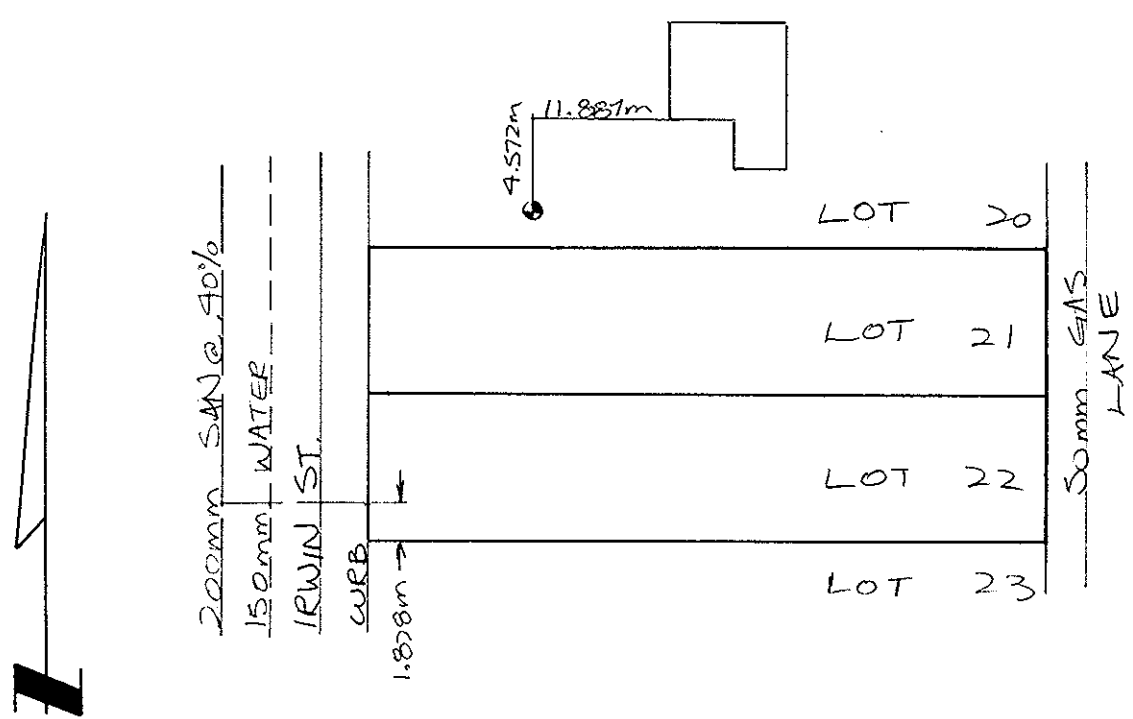

# REPORT TO RECORDS

## WATER SERVICE INFORMATION

Lot No. \_\_\_\_\_ Block \_\_\_\_\_ D.L. \_\_\_\_\_


Address 770. Irwin

Size of Connection  1/2"  3/4"  Other \_\_\_\_\_

Type of Connection  Copper  Iron

Thaw Wire  Yes  No

### LOCATION SKETCH

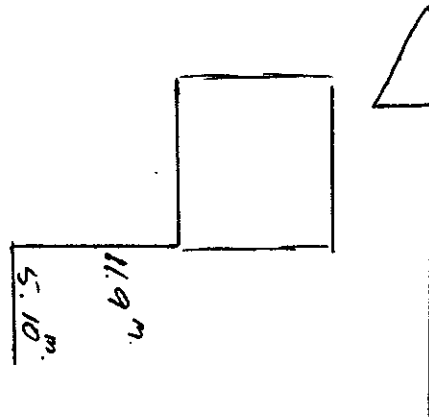

Field Location By R.C Date 6/8/02

Checked by: \_\_\_\_\_