

City of Prince George HISTORY SHEET

SHEET NUMBER **No 3781** Roll Number **006138641**

Legal: LOT'S **C** BLOCK **633** D.L. **633** PLAN **28041**

Address: **2017 W. BITNER ROAD**

Sanitary Connection: # **100mm** SIZE **P.V.C** MATERIAL **101.80** INV. **Aug 11** CONNECTED

Water Connection # **B.I.D.** SIZE **3/4"** MATERIAL **METER** CONNECTED

Storm Connection: # **634** SIZE **MATERIAL** INV. **CONNECTED**

Cash Receipt No's: WATER **B.I.D. Com. 634** SANITARY **634** STORM

CURB FROM PROPERTY LINE **PAVEMENT WIDTH**

B.C. HYDRO **UNDERGROUND CONNECTION**


B.C. TELEPHONE **UNDERGROUND CONNECTION**

INLAND GAS

Information Sheets:

Comments:

SITE PLAN N.T.S.

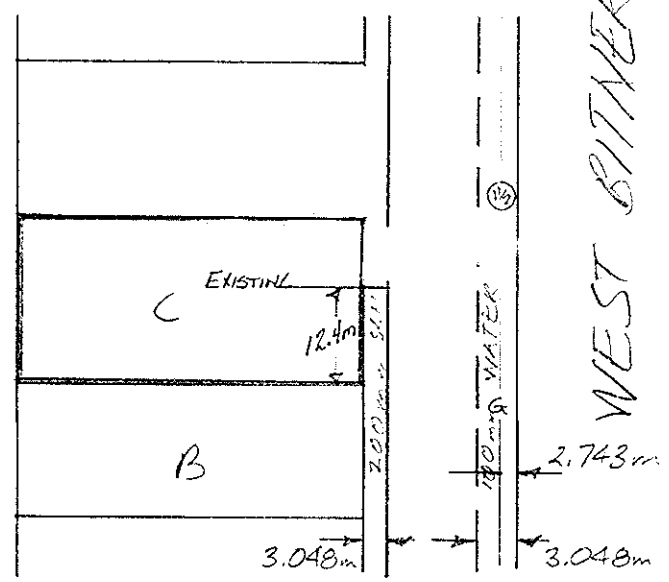

REPORT TO RECORDS

WATER SERVICE INFORMATION

Lot No. _____ Block _____ D.L. _____


Address 2017 E. BITTNER.

Size of Connection 1/2" 3/4" Other _____

Type of Connection Copper Iron

Thaw Wire Yes No

LOCATION SKETCH

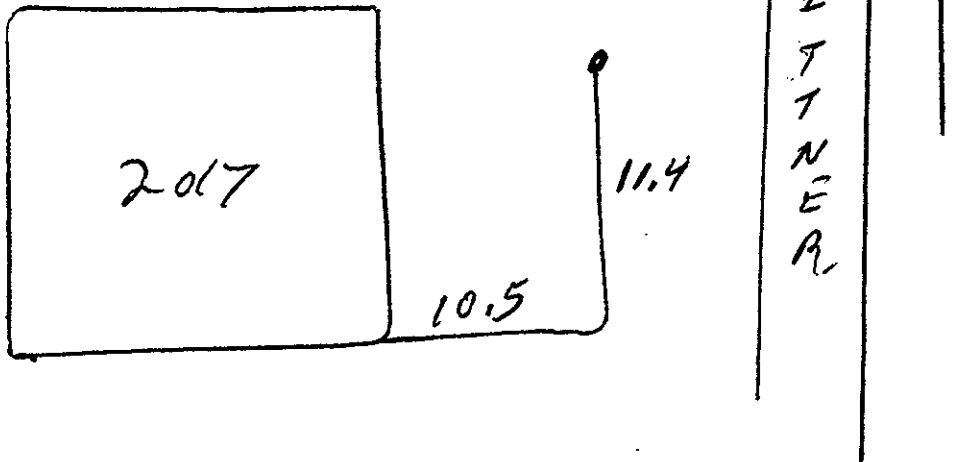

Field Location By A. Labin Date Aug. 28/99

Checked by: _____

REPORT TO RECORDS

SEWER SERVICE INFORMATION

Lot No. _____ Block _____ D.L. _____


Address 2017 E. BETTNER

Size of Connection 100mm 150mm 200mm Other _____

Type of Connection Transite PVC Other _____

Type of Cap Transite Cast Iron

LOCATION SKETCH

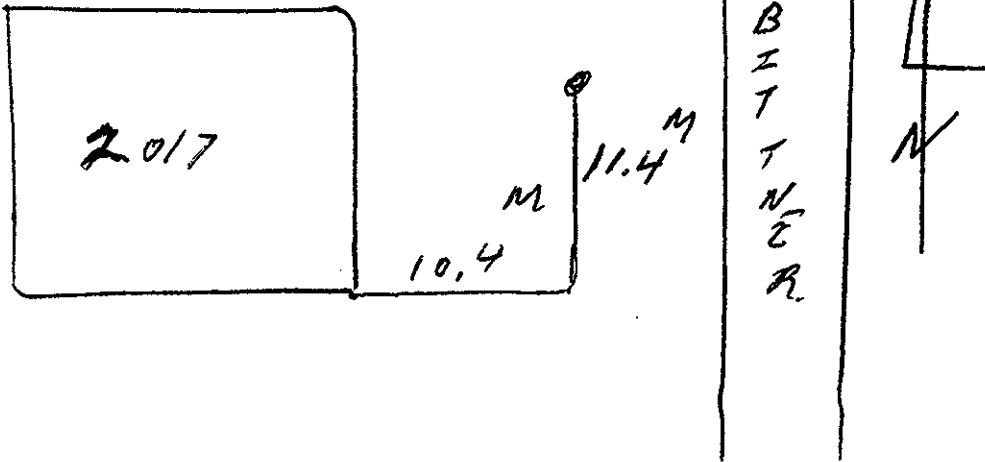

Field Location By Alexis Le Corre Date Aug. 28/95

Checked by Foreman - Sewer Division _____