

City of Prince George

HISTORY SHEET

SHEET NUMBER

PID # 006150977

Legal: LOT'S 66 BLOCK D.L. 913 PLAN 16 511

Address: 180 Mc KENZIE AVE.

Sanitary Connection: # 5722 SIZE 100 mm MATERIAL A.C. INV. 585.970 CONNECTED

Water Connection: # 5722 SIZE 20 mm MATERIAL CU. METER CONNECTED

Storm Connection: # SIZE mm MATERIAL INV. CONNECTED

Cash Receipt No's: WATER SANITARY STORM

CURB FROM PROPERTY LINE 4.877 m PAVEMENT WIDTH 10.363 m

B.C. HYDRO U/G UNDERGROUND CONNECTION



B.C. TELEPHONE U/G UNDERGROUND CONNECTION

INLAND GAS 3.048 m FROM SOUTH SIDE OF MCKENZIE.

Information Sheets:

Comments: WITH THAW WIRE.

**THE INFORMATION CONTAINED HEREIN IS FOR INTERNAL USE ONLY.
NOT TO BE RELIED UPON UNLESS CONFIRMED BY SITE INSPECTION AND/OR INVESTIGATION**

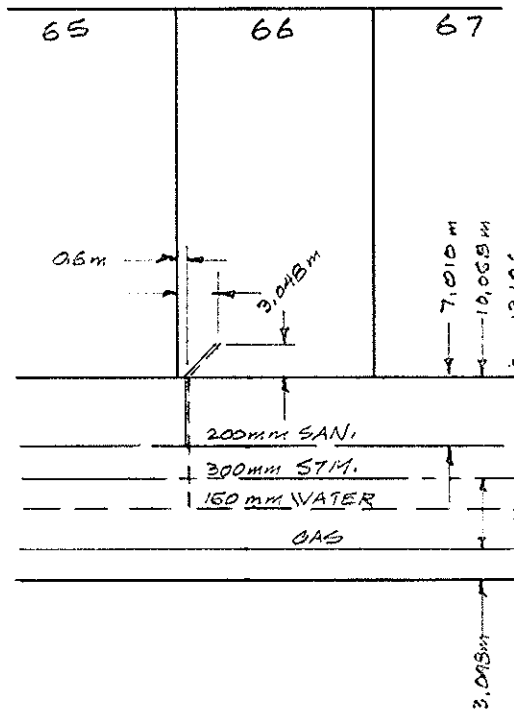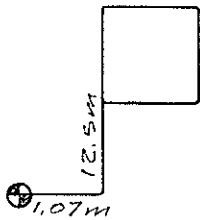

Mc KENZIE AVE.

