

# City of Prince George HISTORY SHEET

SHEET NUMBER \_\_\_\_\_ Roll Number 006165176

Legal: LOT'S A BLOCK \_\_\_\_\_ D.L. 753 PLAN 27973

Address: 4180 **VERSITILE PLACE**

Sanitary Connection: # \_\_\_\_\_ SIZE **100 mm** MATERIAL **PVC** INV. 588.61 CONNECTED

Water Connection # \_\_\_\_\_ SIZE **1"** MATERIAL **Cu.** METER Ø CONNECTED

Storm Connection: # \_\_\_\_\_ SIZE **200 mm** MATERIAL **PVC** INV. \_\_\_\_\_ CONNECTED

Cash Receipt No's: WATER \_\_\_\_\_ SANITARY \_\_\_\_\_ STORM \_\_\_\_\_

CURB FROM PROPERTY LINE **5.0 m** PAVEMENT WIDTH **10.0 m**


B.C. HYDRO **OVERHEAD** UNDERGROUND CONNECTION \_\_\_\_\_

B.C. TELEPHONE **OVERHEAD** UNDERGROUND CONNECTION \_\_\_\_\_

INLAND GAS **N/A**

Information Sheets: **URBAN ENGINEERING DWG. No. 013-100-01 & 013-100-02**

Comments: \_\_\_\_\_

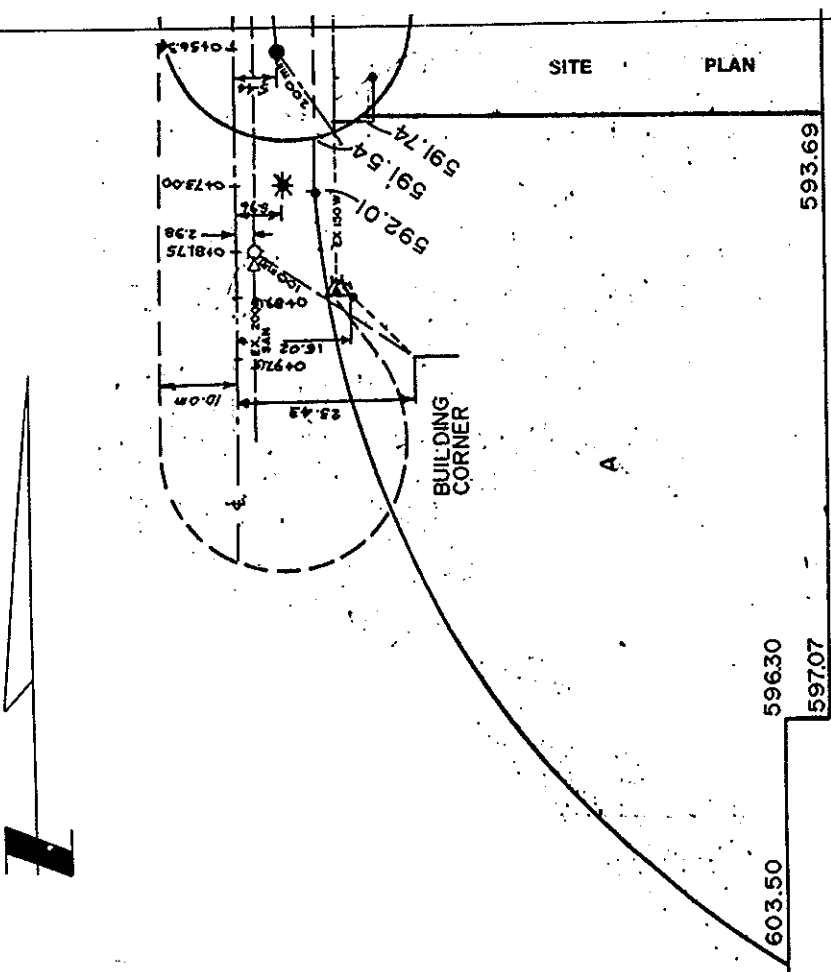

N.T.S.  
CITY OF PRINCE GEORGE  
BENCH MARK No. 1138-79  
EL. = 588.3798 (1930.38')