



City of Prince George
History Sheet

PID:	006166873
SD/MU:	
WO:	5001624

Civic Address: 2802 20th Ave

Legal Description: Lot: 13 Block: L District Lot: 93610005 Plan: 10005


Service Type	Diameter (mm)	Material	Invert Elev at main (m)	Invert Elev at property line (m)	Invert Elev at service end (m)	Distance into property (m)	Installation Date
Sanitary	100mm	AC	585.95	585.98	-	-	December 1963
Water	20mm	Copper	-	-	-	-	December 1962
Storm	N/A	N/A	-	-	-	-	

Service Connection Location				Sanitary (m)	Storm (m)
Distance from downstream San MH	3259	towards upstream San MH	3268	43.70	
Distance from downstream Stm MH	-	towards upstream Stm MH	-		

Power	Size	Communications	Size	Cable	Size	Gas	Size
BC Hydro	-	Telus	-	Shaw	-	FortisBC	-
Overhead Service		Overhead Service		Overhead Service			

Installed by:	Maintenance performed on sanitary service on June 2015	Survey Date:	-
Comments:			

NOT TO SCALE The information contained herein is for internal use only.
Not to be relied on unless confirmed by site inspection and/or investigation.

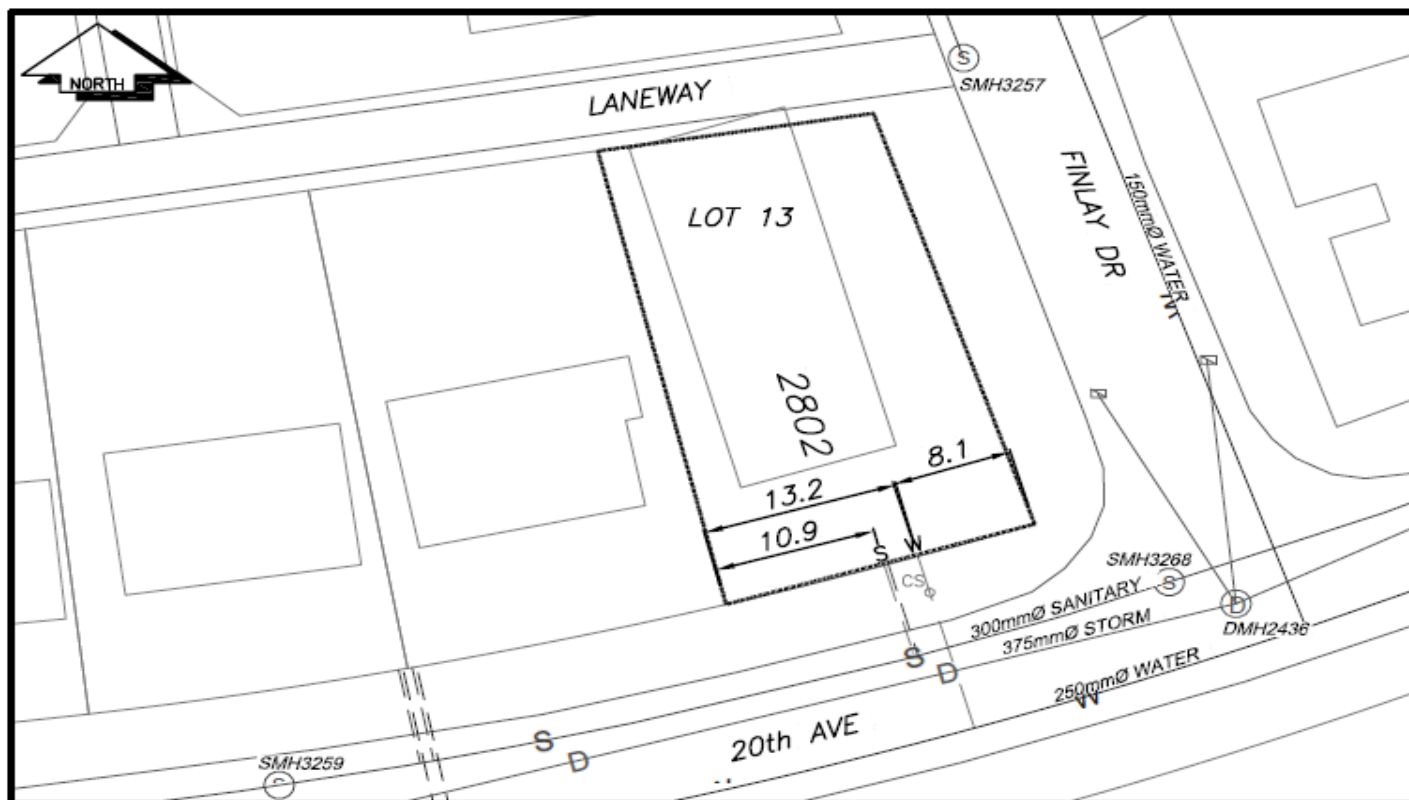

LEGEND:	
CS	CURB STOP
CO	CLEAN OUT
⊗	WATER VALVE
—	WATER SERVICE
- - -	SANITARY SERVICE
⊗	FIRE HYDRANT
○	STORM SERVICE
-G-	GAS
- - -	ENCUMBRANCE

NOT TO SCALE