

City of Prince George HISTORY SHEET

ASSOCIATED ENGINEERING SERVICES LTD.
301 - 1777 THIRD AVENUE
PRINCE GEORGE, B.C. V2L 3G7

SHEET NUMBER **Nº 3148** Roll Number **006168000**

Legal: LOT'S **3** BLOCK D.L. **4045** PLAN **21990**

Address: **2374 SADLER DRIVE**

Sanitary Connection: # SIZE **100 m.m.** MATERIAL **PVC** INV. **726.88 M** CONNECTED

Water Connection # SIZE **18 m.m.** MATERIAL **COPPER** METER CONNECTED

Storm Connection: # SIZE MATERIAL INV. CONNECTED

Cash Receipt No's: WATER SANITARY STORM

CURB FROM PROPERTY LINE **5.0 M (ROLL CURB)** PAVEMENT WIDTH **10.0 M**

B.C. HYDRO UNDERGROUND CONNECTION


B.C. TELEPHONE UNDERGROUND CONNECTION

INLAND GAS

Information Sheets:

Comments: **AESL BENCH MARK : TOP F.H. SPIN ELEV = 733.885**

**@ INTER RIDGEVIEW & NORTH LEG
PANORAMA CRES N/E COR.**

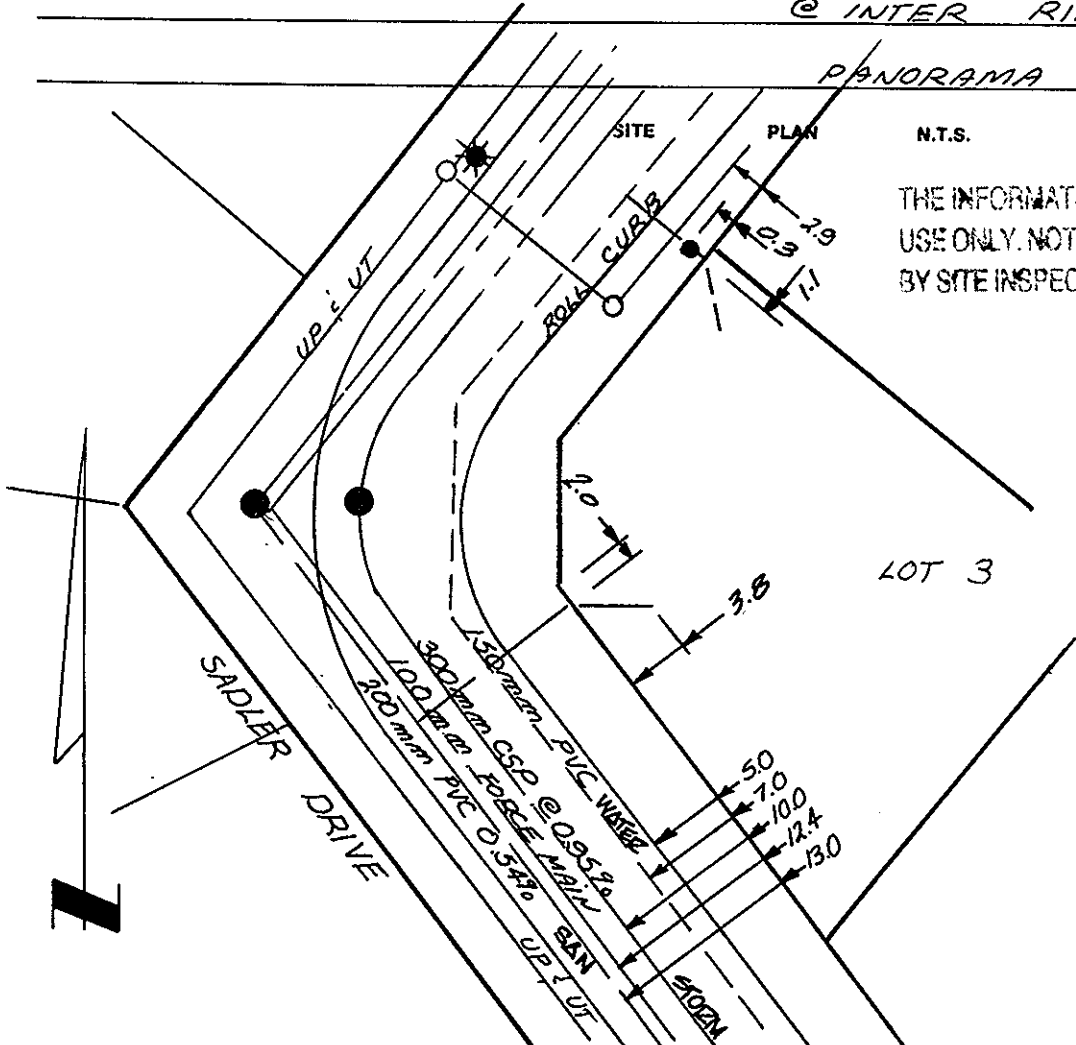

N.T.S.
THE INFORMATION CONTAINED HEREIN IS FOR INTERNAL USE ONLY. NOT TO BE RELIED UPON UNLESS CONFIRMED BY SITE INSPECTION AND/OR INVESTIGATION.