

**City of Prince George
 HISTORY SHEET**

SHEET NUMBER **Nº 3036** Roll Number **006168-5-000**

Legal: LOT'S **21** BLOCK _____ D.L. **ADNS** PLAN **27990**

Address: **2393 SADLER DRIVE**

Sanitary Connection: # _____ SIZE **100 mm** MATERIAL **P.V.C** INV. **726.98** CONNECTED

Water Connection # _____ SIZE **18 mm** MATERIAL **COPPER** METER _____ CONNECTED

Storm Connection: # _____ SIZE _____ MATERIAL _____ INV. _____ CONNECTED

Cash Receipt No's: WATER _____ SANITARY _____ STORM _____

CURB FROM PROPERTY LINE **5.0m (ROLL CURB)** PAVEMENT WIDTH **10.0m**


B.C. HYDRO _____ UNDERGROUND CONNECTION _____

B.C. TELEPHONE _____ UNDERGROUND CONNECTION _____

INLAND GAS _____

Information Sheets: _____

Comments: **AESL BENCH MARK: TOP F.H. SPIN ELEV = 733.885m**
@ INTER RIDGEVIEW S N LEG
PANORAMA CRES N/E COR

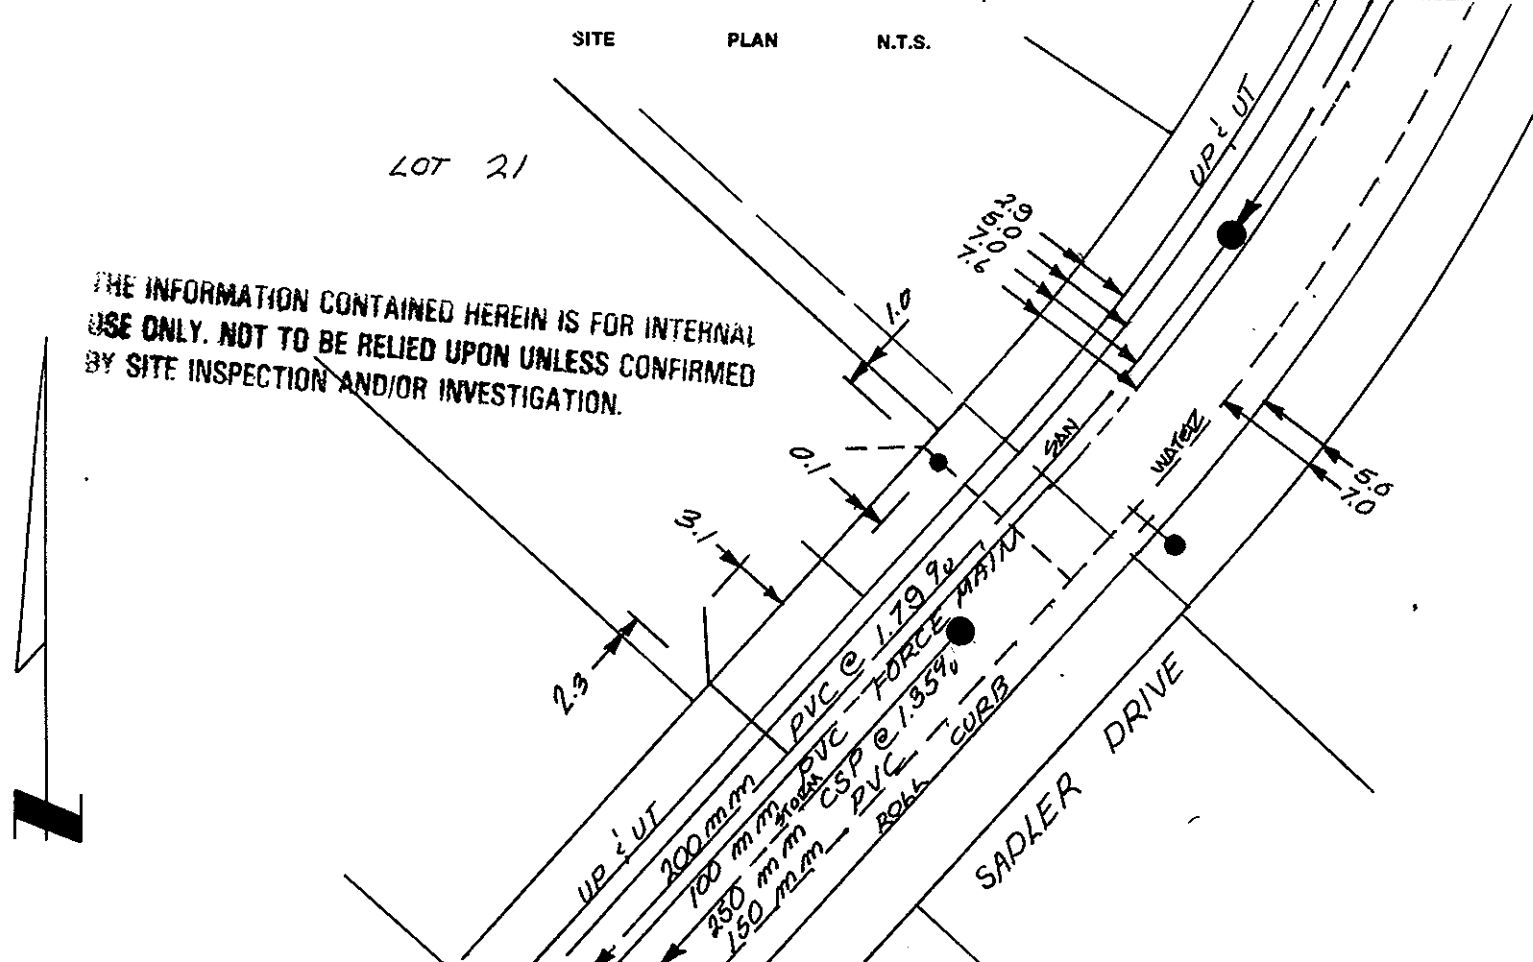

THE INFORMATION CONTAINED HEREIN IS FOR INTERNAL USE ONLY. NOT TO BE RELIED UPON UNLESS CONFIRMED BY SITE INSPECTION AND/OR INVESTIGATION.