

City of Prince George HISTORY SHEET

281
303

SHEET NUMBER _____ Roll Number _____

Legal: LOT'S 3-4-5 BLOCK 16 D.L. 932 PLAN 796

Address: 2306 OAK St

Sanitary Connection: # 6635 SIZE 100mm MATERIAL AC INV. _____ CONNECTED _____

Water Connection # 6635 SIZE 3/4" MATERIAL cu METER _____ CONNECTED _____

Storm Connection: # _____ SIZE _____ MATERIAL _____ INV. _____ CONNECTED _____

Cash Receipt No's: WATER 042 SANITARY 041 STORM _____

CURB FROM PROPERTY LINE _____ PAVEMENT WIDTH _____


B.C. HYDRO _____ UNDERGROUND CONNECTION _____

B.C. TELEPHONE _____ UNDERGROUND CONNECTION _____


INLAND GAS _____

Information Sheets: _____

Comments: _____

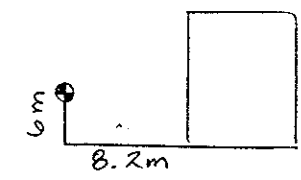

SITE PLAN N.T.S.

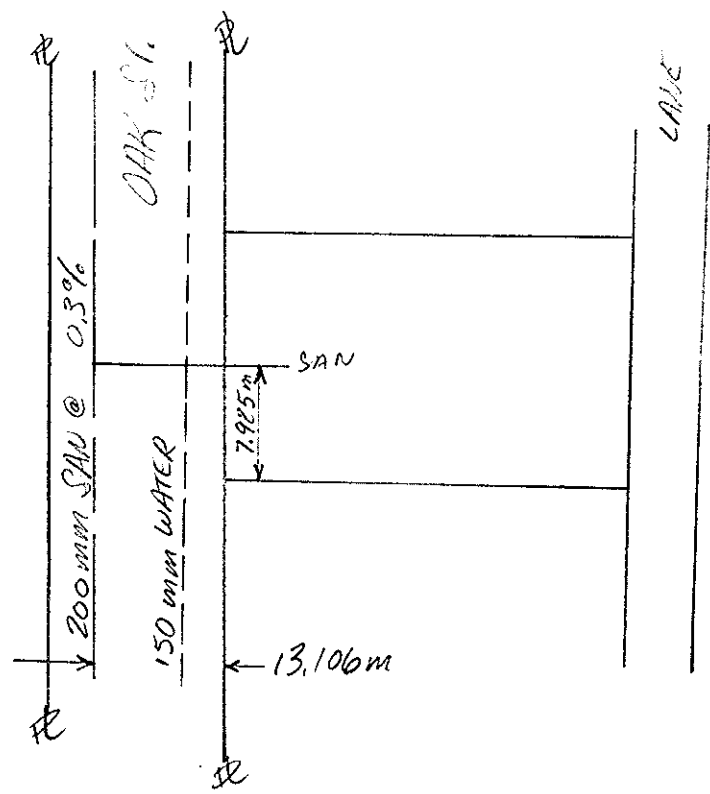

REPORT TO RECORDS

SEWER SERVICE INFORMATION

Lot No. _____ Block _____ D.L. _____


Address 2306 OAK

Size of Connection 100mm 150mm 200mm Other _____

Type of Connection Transite PVC Other _____

Type of Cap Transite Cast Iron

LOCATION SKETCH

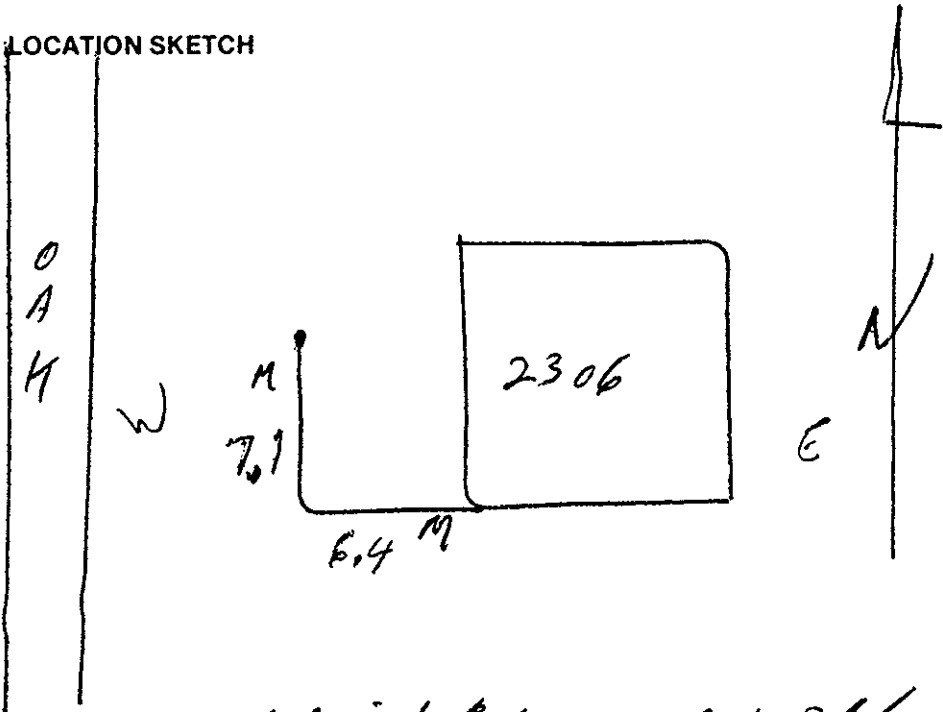

Field Location By A. Smith Date Aug. 28/95

Checked by Foreman - Sewer Division _____