

# City of Prince George HISTORY SHEET

281  
303

SHEET NUMBER

Roll Number

Legal: LOT'S 3-4-5 BLOCK 16 D.L. 932 PLAN 796

Address: 2306 OAK St

Sanitary Connection: # 6635 SIZE 100mm MATERIAL AC INV. \_\_\_\_\_ CONNECTED

Water Connection # 6635 SIZE 3/4" MATERIAL cu METER \_\_\_\_\_ CONNECTED

Storm Connection: # \_\_\_\_\_ SIZE \_\_\_\_\_ MATERIAL \_\_\_\_\_ INV. \_\_\_\_\_ CONNECTED

Cash Receipt No's: WATER 042 SANITARY 041 STORM \_\_\_\_\_

CURB FROM PROPERTY LINE

PAVEMENT WIDTH




B.C. HYDRO \_\_\_\_\_ UNDERGROUND CONNECTION

B.C. TELEPHONE \_\_\_\_\_ UNDERGROUND CONNECTION

INLAND GAS \_\_\_\_\_

Information Sheets: \_\_\_\_\_

Comments: \_\_\_\_\_

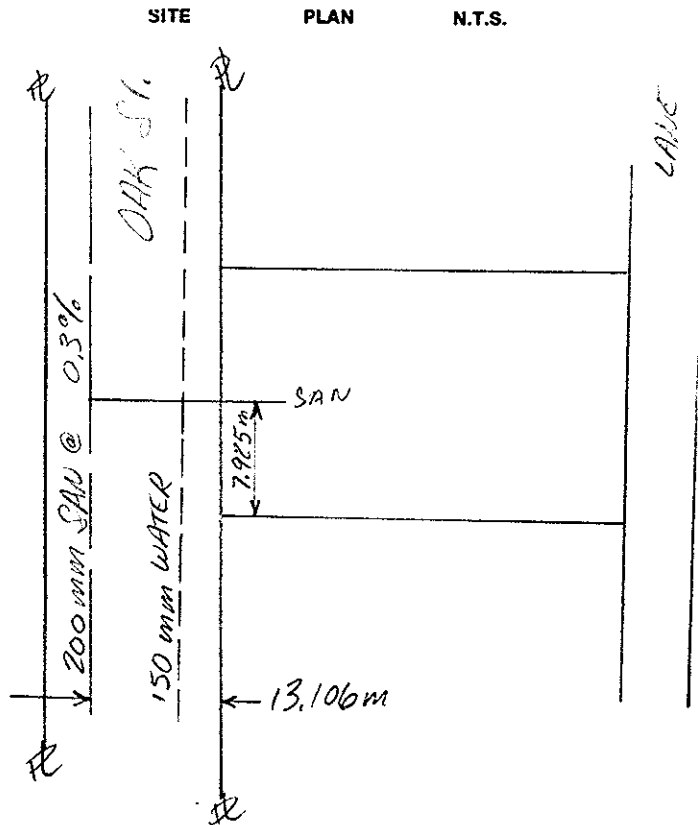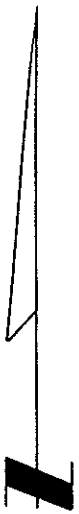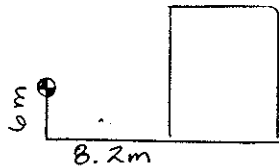

# REPORT TO RECORDS

## SEWER SERVICE INFORMATION

Lot No. \_\_\_\_\_ Block \_\_\_\_\_ D.L. \_\_\_\_\_


Address 2306 OAK

Size of Connection  100mm  150mm  200mm  Other \_\_\_\_\_

Type of Connection  Transite  PVC  Other \_\_\_\_\_

Type of Cap  Transite  Cast Iron

### LOCATION SKETCH

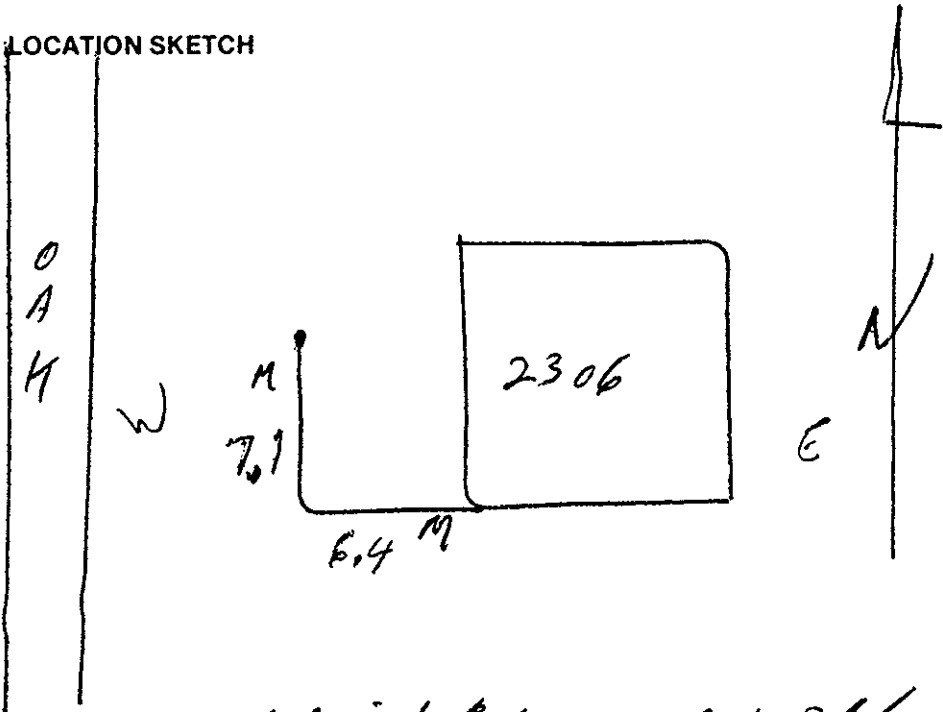

Field Location By A. Smith Date Aug. 28/95

Checked by Foreman - Sewer Division \_\_\_\_\_