

**City of Prince George  
HISTORY SHEET**

006201628 HK

SHEET NUMBER

Roll Number

Legal: LOT'S 3 BLOCK H D.L. 777 PLAN 22 854

Address: 2179 TAMARACK ST

Sanitary Connection: # 11047 SIZE 100 mm MATERIAL A.C INV. 568.901 CONNECTED

Water Connection # 11047 SIZE 20 mm MATERIAL CU. METER CONNECTED

Storm Connection: # \_\_\_\_\_ SIZE \_\_\_\_\_ MATERIAL \_\_\_\_\_ INV. \_\_\_\_\_ CONNECTED \_\_\_\_\_

Cash Receipt No's: WATER \_\_\_\_\_ SANITARY 975 STORM \_\_\_\_\_

CURB FROM PROPERTY LINE 4.877 m PAVEMENT WIDTH 10.363 m

B.C. HYDRO O/H UNDERGROUND CONNECTION \_\_\_\_\_



B.C. TELEPHONE O/H UNDERGROUND CONNECTION \_\_\_\_\_

INLAND GAS 4.572 m FROM R.

Information Sheets:

Comments: WITH THAW WIRE.

**THE INFORMATION CONTAINED HEREIN IS FOR INTERNAL USE ONLY.  
NOT TO BE RELIED UPON UNLESS CONFIRMED BY SITE INSPECTION AND/OR INVESTIGATION**

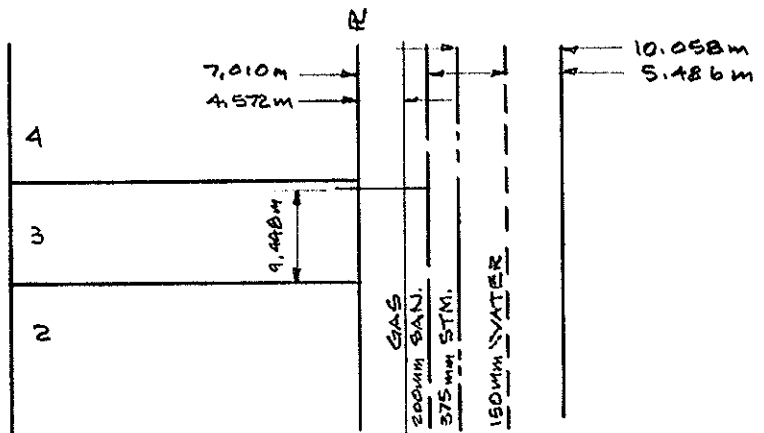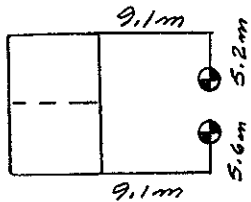

TAMARACK ST.