

006215 142

City of Prince George HISTORY SHEET

FM

SHEET NUMBER

Roll Number

Legal: LOT'S 242 BLOCK — D.L. 782 PLAN 20916

Address: 4475 URQUHART CRES.

Sanitary Connection: # B72B SIZE 100 mm MATERIAL A.C. INV. — CONNECTED

Water Connection # B72B SIZE 20 mm MATERIAL COPPER METER — CONNECTED

Storm Connection: # — SIZE — MATERIAL — INV. — CONNECTED

Cash Receipt No's: WATER — SANITARY — STORM —

CURB FROM PROPERTY LINE 4.877 m PAVEMENT WIDTH 10.363 m

B.C. HYDRO U/G UNDERGROUND CONNECTION



B.C. TELEPHONE U/G UNDERGROUND CONNECTION

INLAND GAS AS SHOWN

Information Sheets:

Comments: WITH THAW WIRE.

THE INFORMATION CONTAINED HEREIN IS FOR INTERNAL USE ONLY.
NOT TO BE RELIED UPON UNLESS CONFIRMED BY SITE INSPECTION AND/OR INVESTIGATION

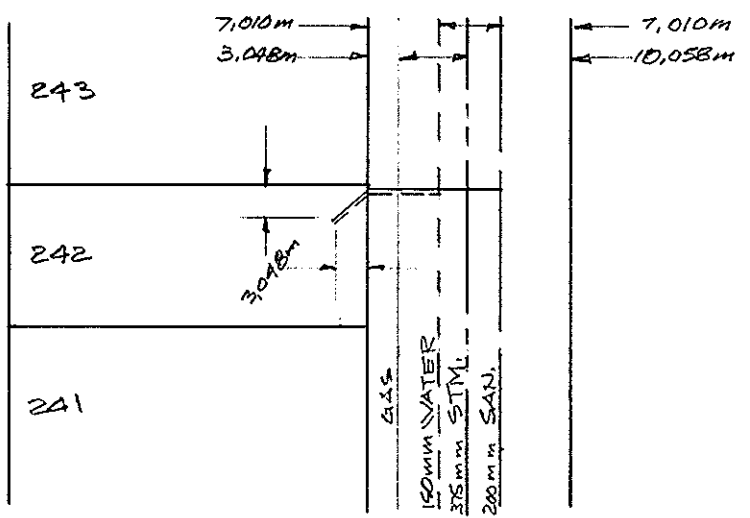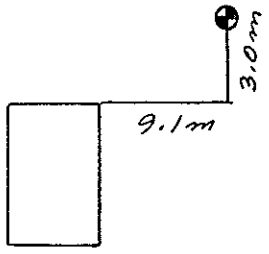

URQUHART
CRES.