

# City of Prince George HISTORY SHEET

SHEET NUMBER

Roll Number 006237631

Legal: LOT'S 47 BLOCK D.L. 938 PLAN 13549

Address: 403 NORTH OGILVIE STREET

Sanitary Connection: # 3595 SIZE MATERIAL INV. CONNECTED

Water Connection # 3595 SIZE 20mm MATERIAL COPPER METER CONNECTED

Storm Connection: # SIZE MATERIAL INV. CONNECTED

Cash Receipt No's: WATER SANITARY STORM

CURB FROM PROPERTY LINE PAVEMENT WIDTH


B.C. HYDRO UNDERGROUND CONNECTION

B.C. TELEPHONE UNDERGROUND CONNECTION

INLAND GAS

Information Sheets:

Comments:

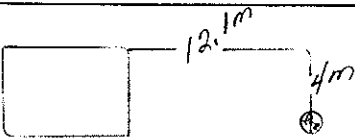

SITE PLAN N.T.S.

