



City of Prince George  
**History Sheet**

PID:	006248225
MU:	102226
WO:	101348

Civic Address: 4131 Rainbow Dr  
 Legal Description: Lot: 1 District Lot: 2507 Plan: 32034

Service Type	Diameter (mm)	Material	Invert Elev at main (m)	Invert Elev at property line (m)	Invert Elev at service end (m)	Distance into property (m)	Installation Date
Sanitary (S1)	150mm	AC	-	-	-	-	January 1967
Water (1)	100mm	CI	-	-	-	-	January 1966
Water (2)	150mm	CI	-	-	-	-	January 1966
Water (3)	150mm	PVC	600.30	600.60	-	-	August 2020
Storm (1)	200mm	Vit	-	-	-	-	


Service Connection Location	Sanitary (m)	Storm (m)
150mm Sanitary service connected to San MH2734	-	
200mm Storm service connected to Stm MH2095		

Power	Size	Communications	Size	Cable	Size	Gas	Size
BC Hydro	-	Telus	-	Shaw	-	FortisBC	-
Underground Service		Underground Service		Underground Service			

Installed by: City of Prince George forces Survey Date: -

Comments:

**NOT TO SCALE** The information contained herein is for internal use only.  
 Not to be relied on unless confirmed by site inspection and/or investigation.

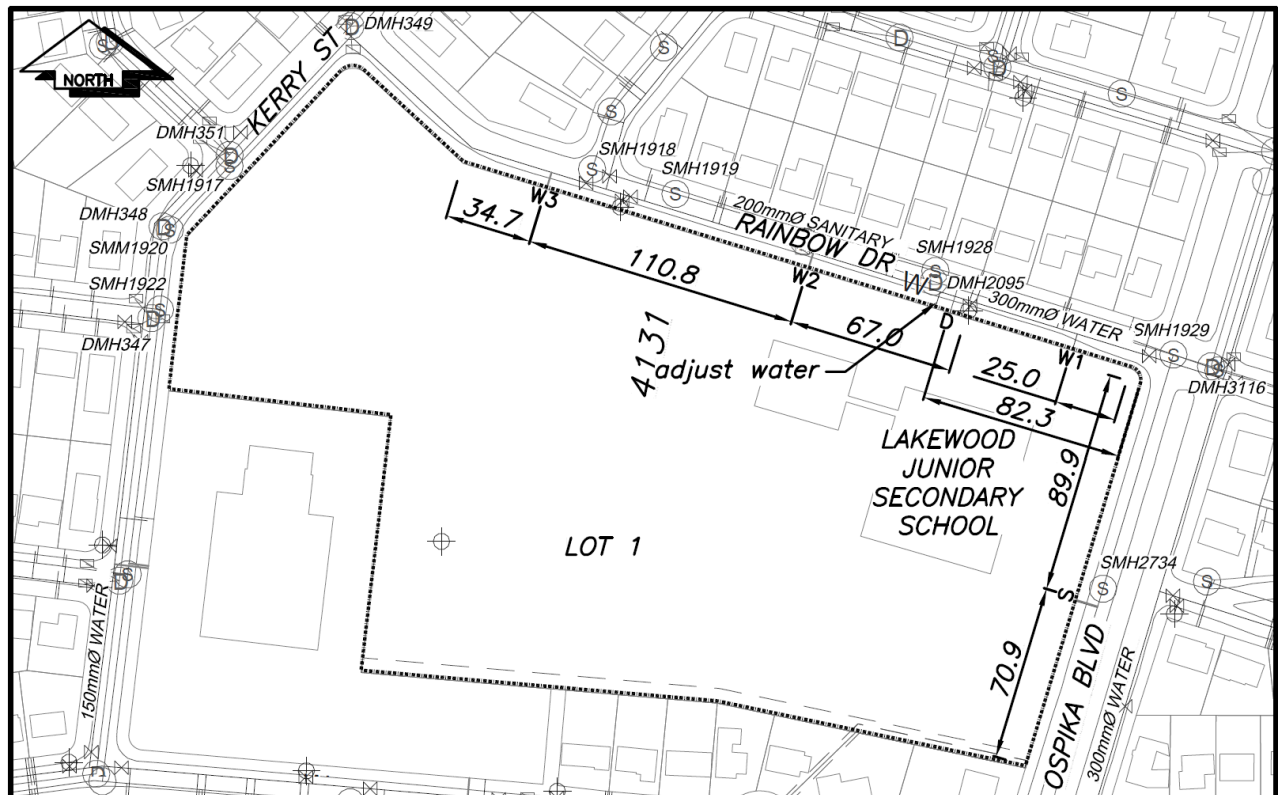

LEGEND:	
CS <sup>o</sup>	CURB STOP
CO <sup>o</sup>	CLEAN OUT
⊗	WATER VALVE
— —	WATER SERVICE
- - - -	SANITARY SERVICE
⊗	FIRE HYDRANT
—o—	STORM SERVICE
—G—	GAS
- - - -	ENCUMBRANCE

**NOT TO SCALE**