



City of Prince George
History Sheet

PID:	006257721
MU:	101428
WO:	

Civic Address: 5354 Shellburn Rd

Legal Description: Lot: A District Lot: 954 Plan: 14964 except Plan 27408 and EPP66309


Service Type	Diameter (mm)	Material	Invert Elev at main (m)	Invert Elev at property line (m)	Invert Elev at service end (m)	Distance into property (m)	Installation Date
Sanitary	200mm	PVC	-	-	-	-	July 2013
Water	200mm	PVC	-	-	-	-	July 2013
Storm	N/A	N/A	-	-	-	-	

Service Connection Location	Sanitary (m)	Storm (m)
200mm Sanitary stub connected to San MH5386	-	
Distance from downstream Stm MH - towards upstream Stm MH	-	

Power	Size	Communications	Size	Cable	Size	Gas	Size
BC Hydro	-	Telus	-	Shaw	-	FortisBC	-
Overhead Service		Overhead Service		Overhead Service			

Installed by:	Survey Date:	-
Comments:		

NOT TO SCALE The information contained herein is for internal use only.
Not to be relied on unless confirmed by site inspection and/or investigation.

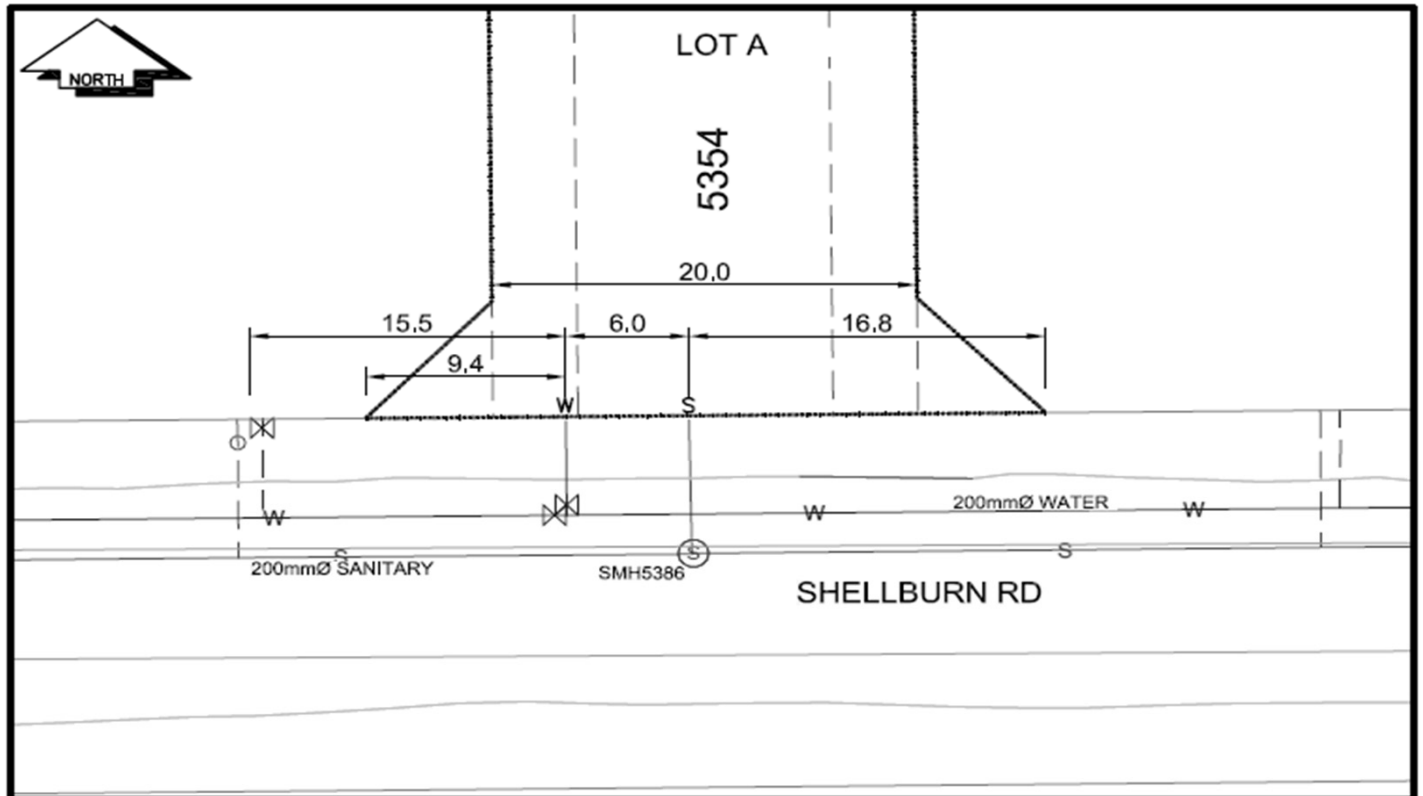

LEGEND:			
CS ^o	CURB STOP	--- W ---	WATER SERVICE
CO ^o	CLEAN OUT	--- S ---	SANITARY SERVICE
⊗	WATER VALVE	⊗	FIRE HYDRANT
		--- G ---	GAS
		---	ENCUMBRANCE

NOT TO SCALE