



City of Prince George  
**History Sheet**

PID:	006263682
SD/MU:	
WO:	

Civic Address: 4090 Cormack Cres

Legal Description: Lot: 32 District Lot: 905 Plan: 27754


Service Type	Diameter (mm)	Material	Invert Elev at main (m)	Invert Elev at property line (m)	Invert Elev at service end (m)	Distance into property (m)	Installation Date
Sanitary	100mm	PVC	-	643.17	-	-	December 1980
Water	20mm	Copper	-	-	-	-	December 1980
Storm	100mm	PVC	-	643.35	-	-	December 1980

Service Connection Location				Sanitary (m)	Storm (m)
Distance from downstream San MH	3619	towards upstream San MH	3618	8.41	
Distance from downstream Stm MH	1794	towards upstream Stm MH	1799	-	10.54

Power	Size	Communications	Size	Cable	Size	Gas	Size
BC Hydro	-	Telus	-	Shaw	-	FortisBC	-
Underground Service		Underground Service		Underground Service			

Installed by:		Survey Date:	-
Comments:	Water service location confirmed June 30, 2017		

**NOT TO SCALE** The information contained herein is for internal use only.  
Not to be relied on unless confirmed by site inspection and/or investigation.

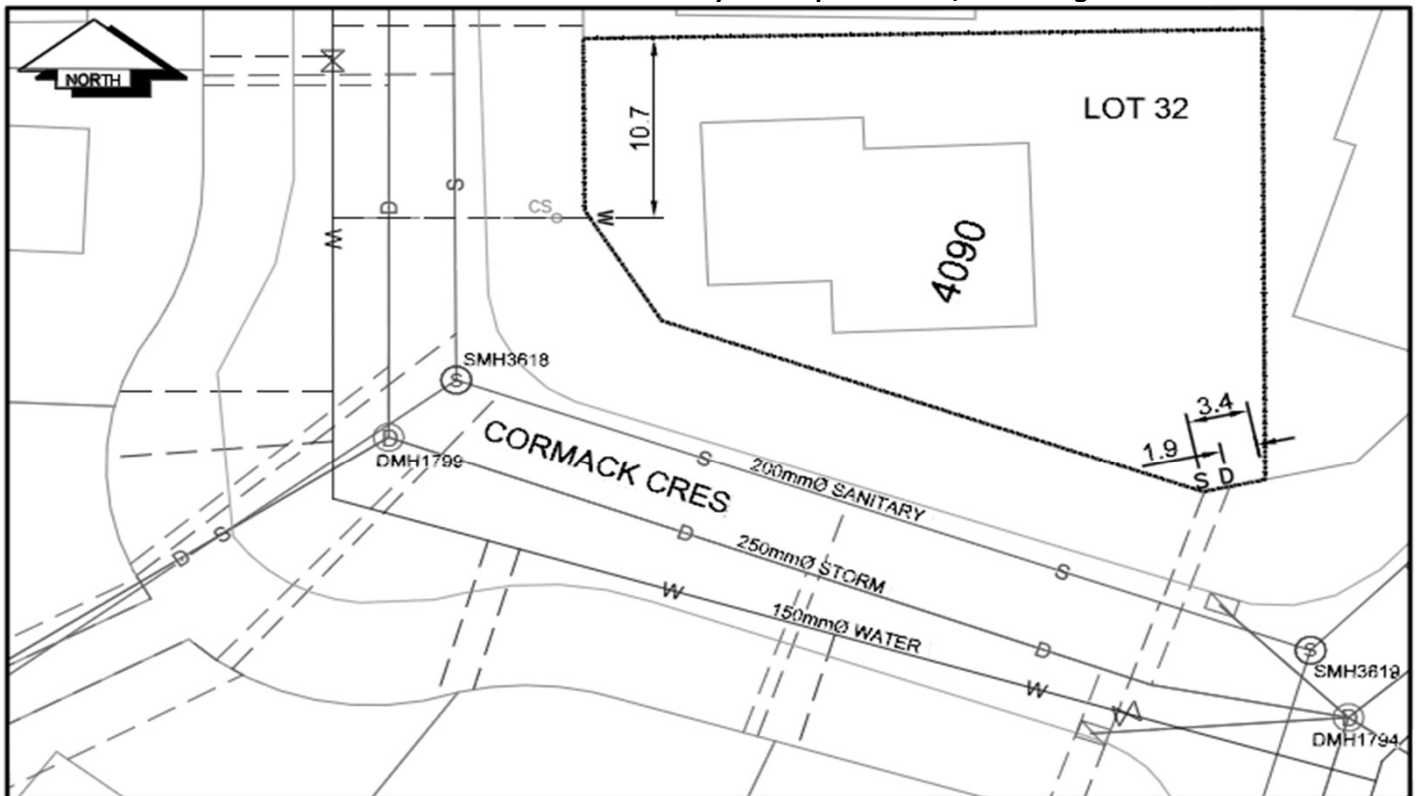

CS <sup>o</sup> CURB STOP	--- W WATER SERVICE	--- S STORM SERVICE
CO <sup>o</sup> CLEAN OUT	--- S SANITARY SERVICE	--- G GAS
⊗ WATER VALVE	⊗ FIRE HYDRANT	--- ENCUMBRANCE

**NOT TO SCALE**