



City of Prince George
History Sheet

PID:	006264981
MU:	101369
WO:	

Civic Address: 4198 Davis Rd

Legal Description: Lot: 61 District Lot: 905 Plan: 27754


Service Type	Diameter (mm)	Material	Invert Elev at main (m)	Depth of Cut at property line (m)	Invert Elev at service end (m)	Distance into property (m)	Installation Date
Sanitary	200mm	PVC	-	3.50	642.60	-	February 2013
Water	150mm	PVC	-	-	-	-	
Storm	100mm	PVC	-	-	-	-	

Service Connection Location	Sanitary (m)	Storm (m)
200mm sanitary sewer connection connexed to SMH 5274	-	
100mm storm sewer service connected to DMH1835		

Power	Size	Communications	Size	Cable	Size	Gas	Size
BC Hydro	-	Telus	-	Shaw	-	FortisBC	-
Underground Service		Underground Service		Underground Service			

Installed by: IDL	Survey Date: -
Comments:	

NOT TO SCALE The information contained herein is for internal use only.
Not to be relied on unless confirmed by site inspection and/or investigation.

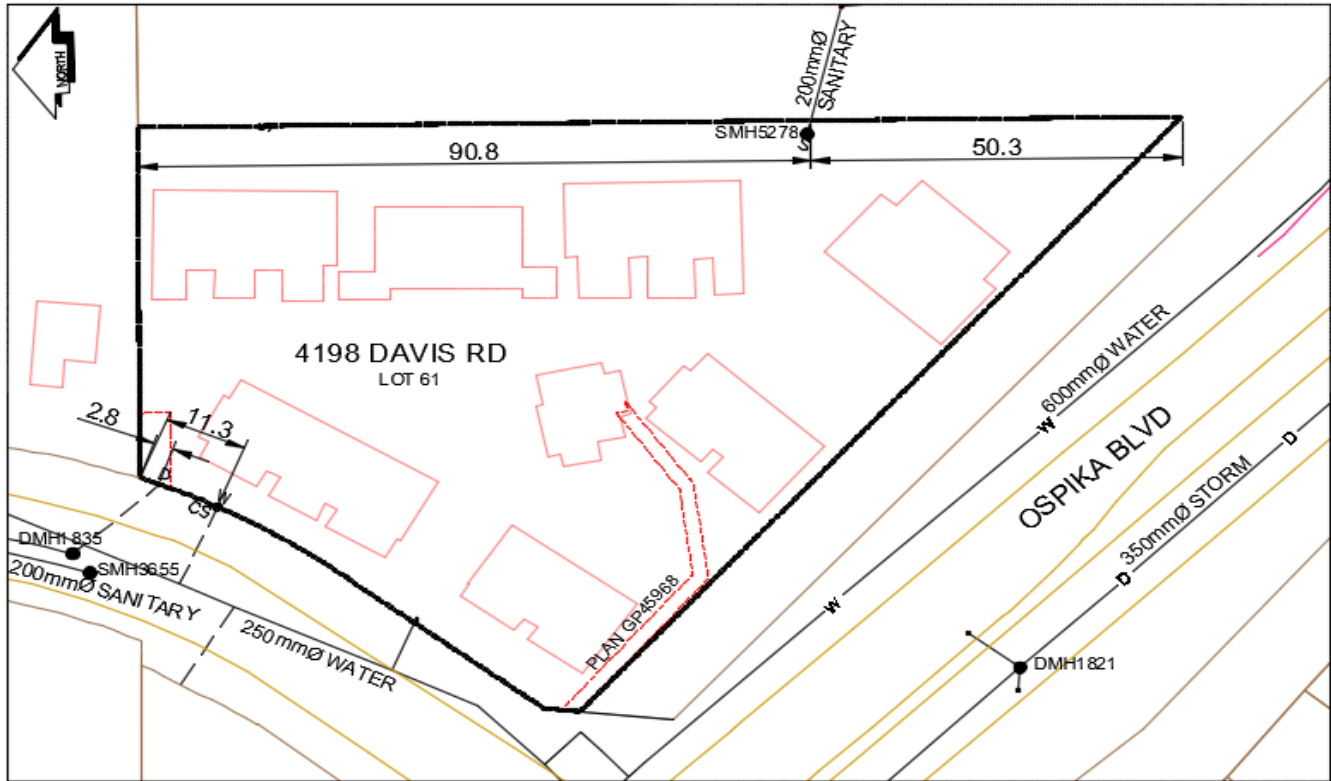

LEGEND:

CS ^o CURB STOP	--- WATER SERVICE	--- STORM SERVICE
CO ^o CLEAN OUT	--- SANITARY SERVICE	--- G --- GAS

NOT TO SCALE