

City of Prince George HISTORY SHEET

5

SHEET NUMBER

Roll Number **006267645**

Legal: LOT'S **C** BLOCK D.L. **2424** PLAN **27771**

Address: **8144 FLAMINGO ROAD**

Sanitary Connection: # SIZE **100MM** MATERIAL **PVC** INV. **2.6M** CONNECTED

Water Connection # SIZE **20mm** MATERIAL **CW** METER CONNECTED

Storm Connection: # SIZE MATERIAL INV. CONNECTED

Cash Receipt No's: WATER SANITARY STORM

CURB FROM PROPERTY LINE PAVEMENT WIDTH

B.C. HYDRO UNDERGROUND CONNECTION


B.C. TELEPHONE UNDERGROUND CONNECTION

INLAND GAS

Information Sheets:

Comments:

The information contained herein is for internal use only. Not to be relied upon unless confirmed by site inspection and/or investigation.

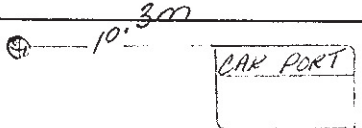

SITE PLAN N.T.S.

FLAMINGO RD.

