

Lot Servicing


950 WOLCZUK RD 967 WOLCZUK RD
Lot: B, Plan: 27963, DL: 2611 & DL 823

PID: 006268871

SERVICE	SIZE	MATERIAL	INSTALLED DATE	LOCATION	DETAILS
Water	N/A			No service available	
Sewer	N/A			No service available	



- Sanitary
- - Storm
- - Water
- 25 Lot Number

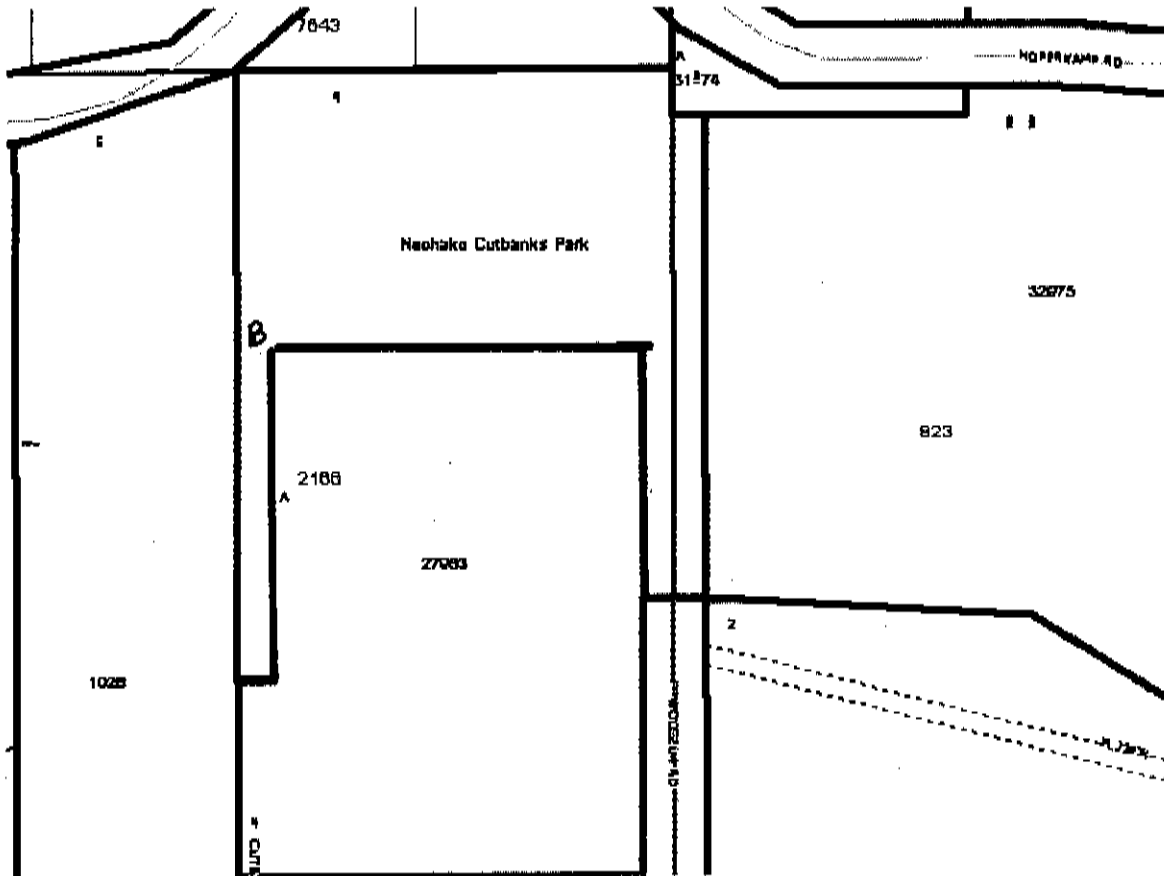

Accuracy not guaranteed unless confirmed by site inspection and/or investigation.
 Connection location between main and property line only.