

**City of Prince George
HISTORY SHEET**

SHEET NUMBER

Roll Number 006285333

Legal: LOT'S 167 BLOCK _____ D.L. 2507 PLAN 20916

Address: 4322 GRANITE AVE.

Sanitary Connection: # 8550 SIZE 100mm MATERIAL A.C. INV. _____ CONNECTED _____

Water Connection # 8550 SIZE 20mm MATERIAL Cu. METER _____ CONNECTED _____

Storm Connection: # _____ SIZE _____ MATERIAL _____ INV. _____ CONNECTED _____

Cash Receipt No's: WATER _____ SANITARY _____ STORM _____

CURB FROM PROPERTY LINE 4.877m PAVEMENT WIDTH 10.363m

B.C. HYDRO U/G UNDERGROUND CONNECTION _____



B.C. TELEPHONE U/G UNDERGROUND CONNECTION _____

INLAND GAS AS SHOWN

Information Sheets: _____

Comments: _____

**THE INFORMATION CONTAINED HEREIN IS FOR INTERNAL USE ONLY.
NOT TO BE RELIED UPON UNLESS CONFIRMED BY SITE INSPECTION AND/OR INVESTIGATION**

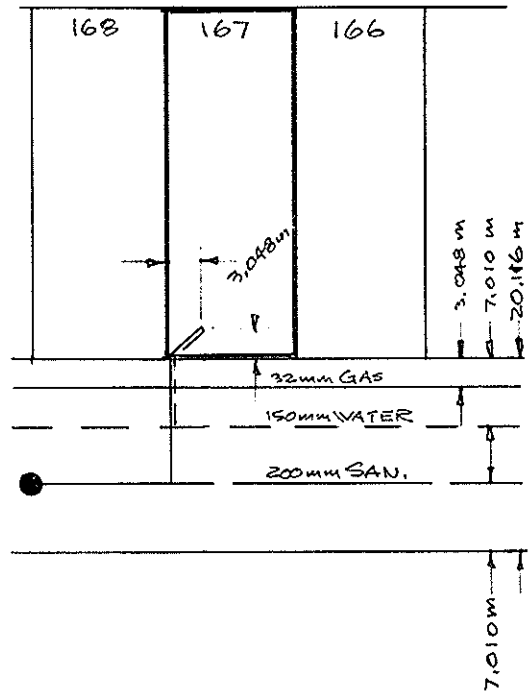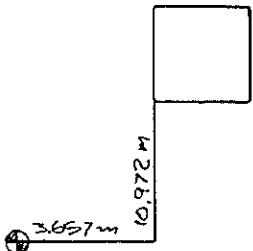

GRANITE AVE.

