

# City of Prince George HISTORY SHEET

SHEET NUMBER

Roll Number *006322085*

Legal: LOT'S *68* BLOCK D.L. *753* PLAN *16085*

Address: *5549 YORK DRIVE*

Sanitary Connection: # SIZE MATERIAL INV. CONNECTED

Water Connection # SIZE *20 mm* MATERIAL *CU* METER CONNECTED

Storm Connection: # SIZE MATERIAL INV. CONNECTED

Cash Receipt No's: WATER SANITARY STORM

CURB FROM PROPERTY LINE PAVEMENT WIDTH


B.C. HYDRO UNDERGROUND CONNECTION

B.C. TELEPHONE UNDERGROUND CONNECTION

INLAND GAS

Information Sheets:

Comments:

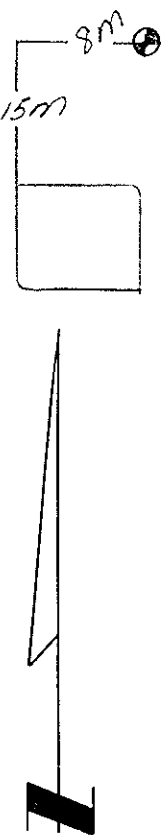

SITE PLAN N.T.S.

