

City of Prince George HISTORY SHEET

SHEET NUMBER **5798** Roll Number **006337**

Legal: LOT'S **82** BLOCK **2003** D.L. **2003** PLAN **27722**

Address: **6128 BERGER PLACE GAGNON PL.**

Sanitary Connection: # SIZE **100 mm** MATERIAL **P.V.C.** INV. **76.25** CONNECTED

Water Connection # SIZE **18 mm** MATERIAL **COPPER** METER CONNECTED

Storm Connection: # SIZE MATERIAL INV. CONNECTED

Cash Receipt No's: WATER SANITARY STORM

CURB FROM PROPERTY LINE **5^m** **(ROLL CURB)** PAVEMENT WIDTH **10^m**


B.C. HYDRO UNDERGROUND CONNECTION

B.C. TELEPHONE UNDERGROUND CONNECTION

INLAND GAS

Information Sheets:

Comments: **BENCHMARK: #1969-ELEV 777.186 m**
TOP F.H. S/W COR HIGHLAND
& MONTGOMERY W/LEG.

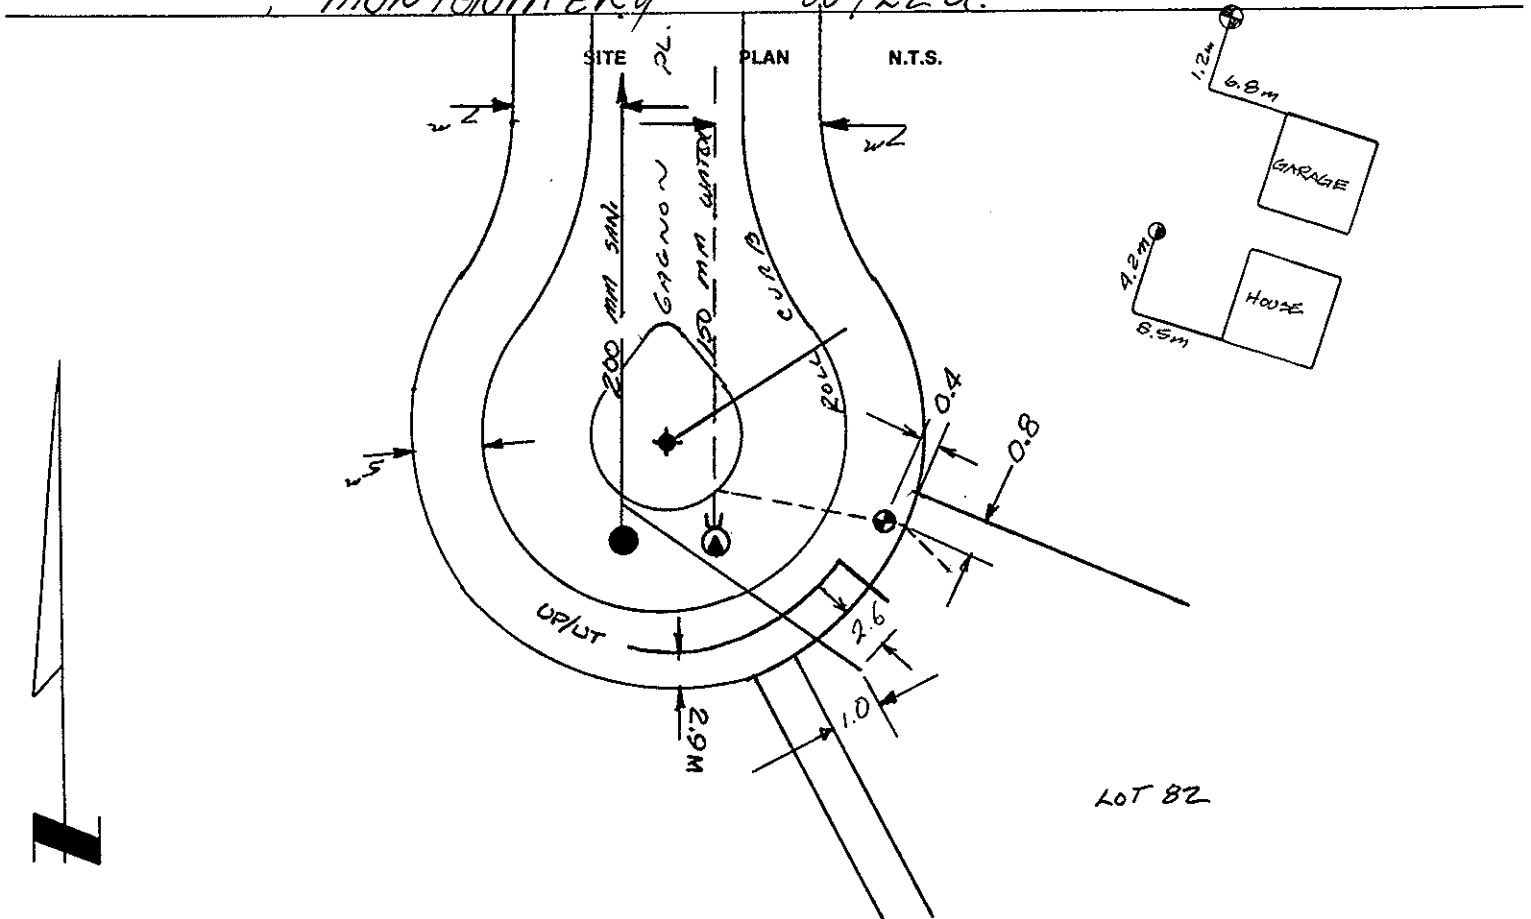

Lot 82