

**City of Prince George
HISTORY SHEET**

SHEET NUMBER **5730** Roll Number **306332309**

Legal: LOT'S **31** BLOCK D.L. **4016 2003** PLAN **27722**

Address: **6446 BURKITT ROAD**

Sanitary Connection: # SIZE **100 mm** MATERIAL **P.V.C.** INV. **75.99** CONNECTED

Water Connection # SIZE **18 mm** MATERIAL **COPPER** METER CONNECTED

Storm Connection: # SIZE MATERIAL INV. CONNECTED

Cash Receipt No's: WATER SANITARY STORM

CURB FROM PROPERTY LINE **5^m** (ROLL CURB) PAVEMENT WIDTH **10m**

B.C. HYDRO UNDERGROUND CONNECTION

B.C. TELEPHONE UNDERGROUND CONNECTION


INLAND GAS

Information Sheets:

Comments: **BENCH MARK : #1969 - ELEV 777.168M**

THE INFORMATION CONTAINED HEREIN IS FOR INTER
USE ONLY. NOT TO BE RELIED UPON UNLESS CONFIRMED
BY SITE INSPECTION AND/OR INVESTIGATION.

**TOP F.H. S/W COR HIGHLAND
& MONTGOMERY W/LEG**

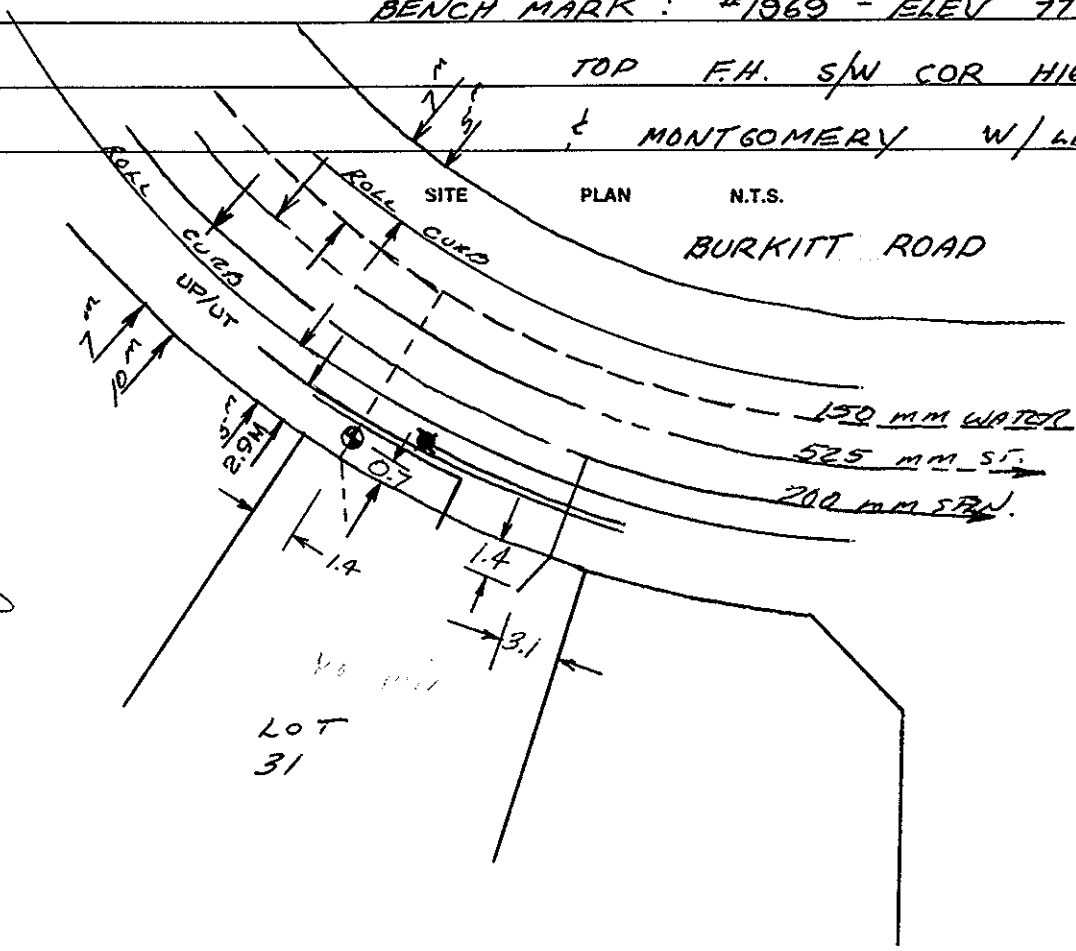

[Handwritten signature]