

**City of Prince George
HISTORY SHEET**

SHEET NUMBER **5739** Roll Number **00639732**

Legal: LOT'S **46** BLOCK _____ D.L. **1048 2003** PLAN **27722**

Address: **6221 TRISA PL.**

Sanitary Connection: # _____ SIZE **100 mm** MATERIAL **P.V.C.** INV. **78.70** CONNECTED

Water Connection # _____ SIZE **18 mm** MATERIAL **COPPER** METER _____ CONNECTED

Storm Connection: # _____ SIZE _____ MATERIAL _____ INV. _____ CONNECTED

Cash Receipt No's: WATER _____ SANITARY _____ STORM _____

CURB FROM PROPERTY LINE **5^m** (ROLL CURB) PAVEMENT WIDTH **10^m**

B.C. HYDRO _____ UNDERGROUND CONNECTION _____

B.C. TELEPHONE _____


INLAND GAS _____

Information Sheets: _____

Comments: **BENCH MARK: #1969 - ELEV 777.186 M**

TOP F.H. S/W COR

1/4 MONTGOMERY S/LEG

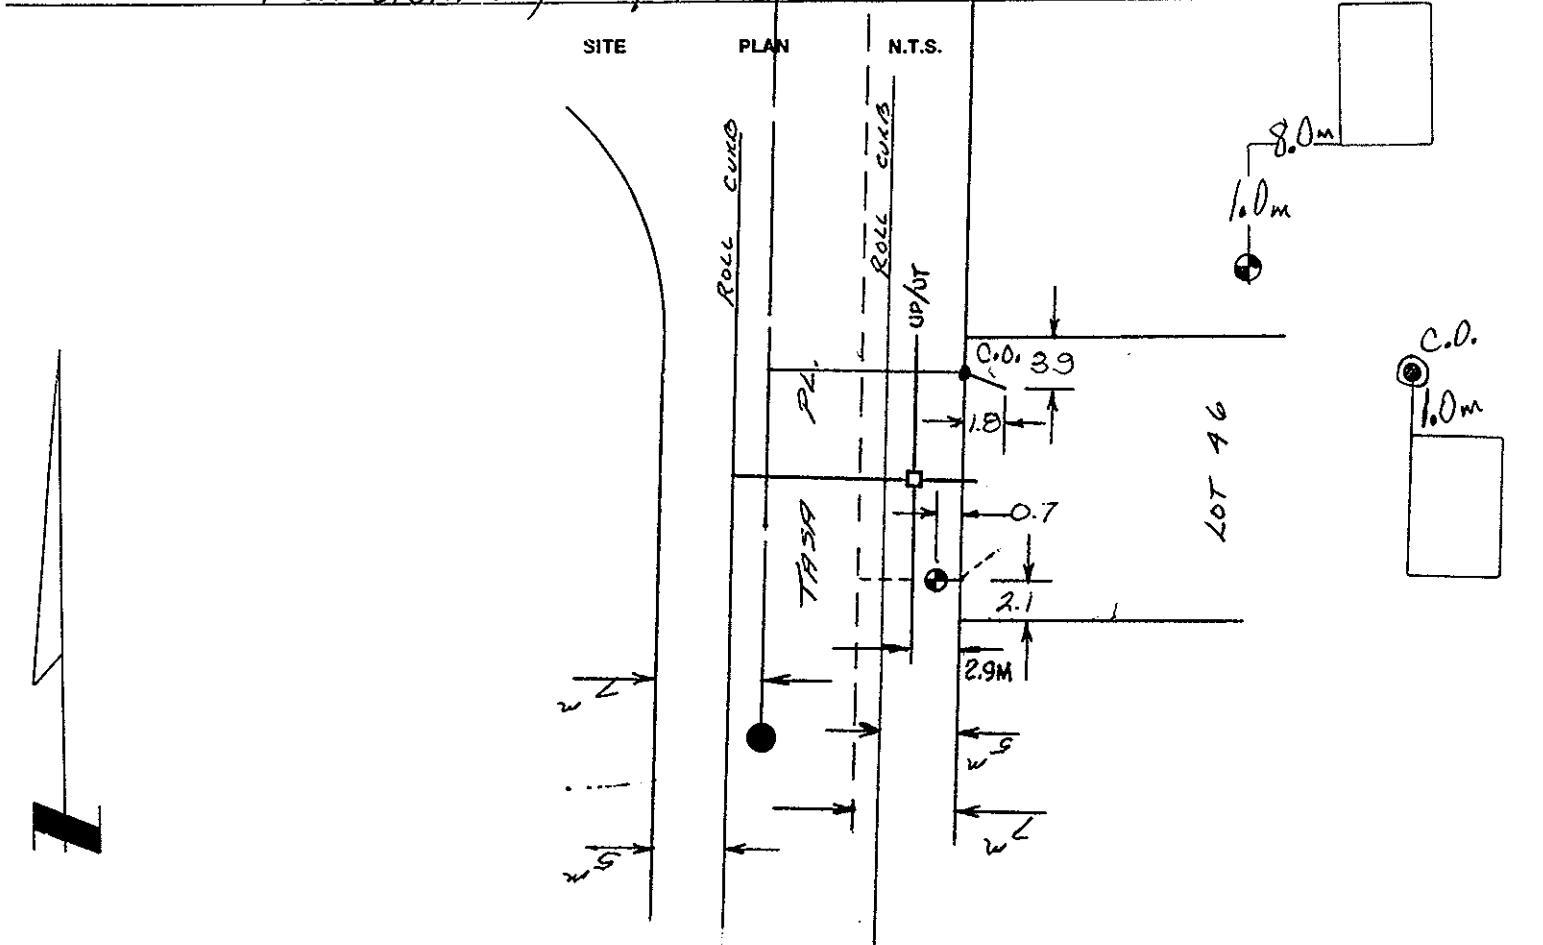

THE INFORMATION CONTAINED HEREIN IS FOR INTERNAL
USE ONLY. NOT TO BE RELIED UPON UNLESS CONFIRMED
BY SITE INSPECTION AND/OR INVESTIGATION.