

City of Prince George HISTORY SHEET

SHEET NUMBER _____ Roll Number 006342621

Legal: LOT'S 41 BLOCK _____ D.L. 4048 PLAN 27722

Address: 6243 BERGER CRESCENT

Sanitary Connection: # _____ SIZE 100 mm MATERIAL P.V.C. INV. 70.35 CONNECTED

Water Connection # _____ SIZE 18 mm MATERIAL COPPER METER _____ CONNECTED

Storm Connection: # _____ SIZE _____ MATERIAL _____ INV. _____ CONNECTED

Cash Receipt No's: WATER _____ SANITARY _____ STORM _____

CURB FROM PROPERTY LINE 5^m (ROLL CURB) PAVEMENT WIDTH 10^m


B.C. HYDRO _____ UNDERGROUND CONNECTION _____

B.C. TELEPHONE _____ UNDERGROUND CONNECTION _____

INLAND GAS _____

Information Sheets: _____

Comments: BENCH MARK : #1969 - ELEV 777.168M
TOP F.H. S/W COR HIGHLAND
S' MONTGOMERY W/LEG

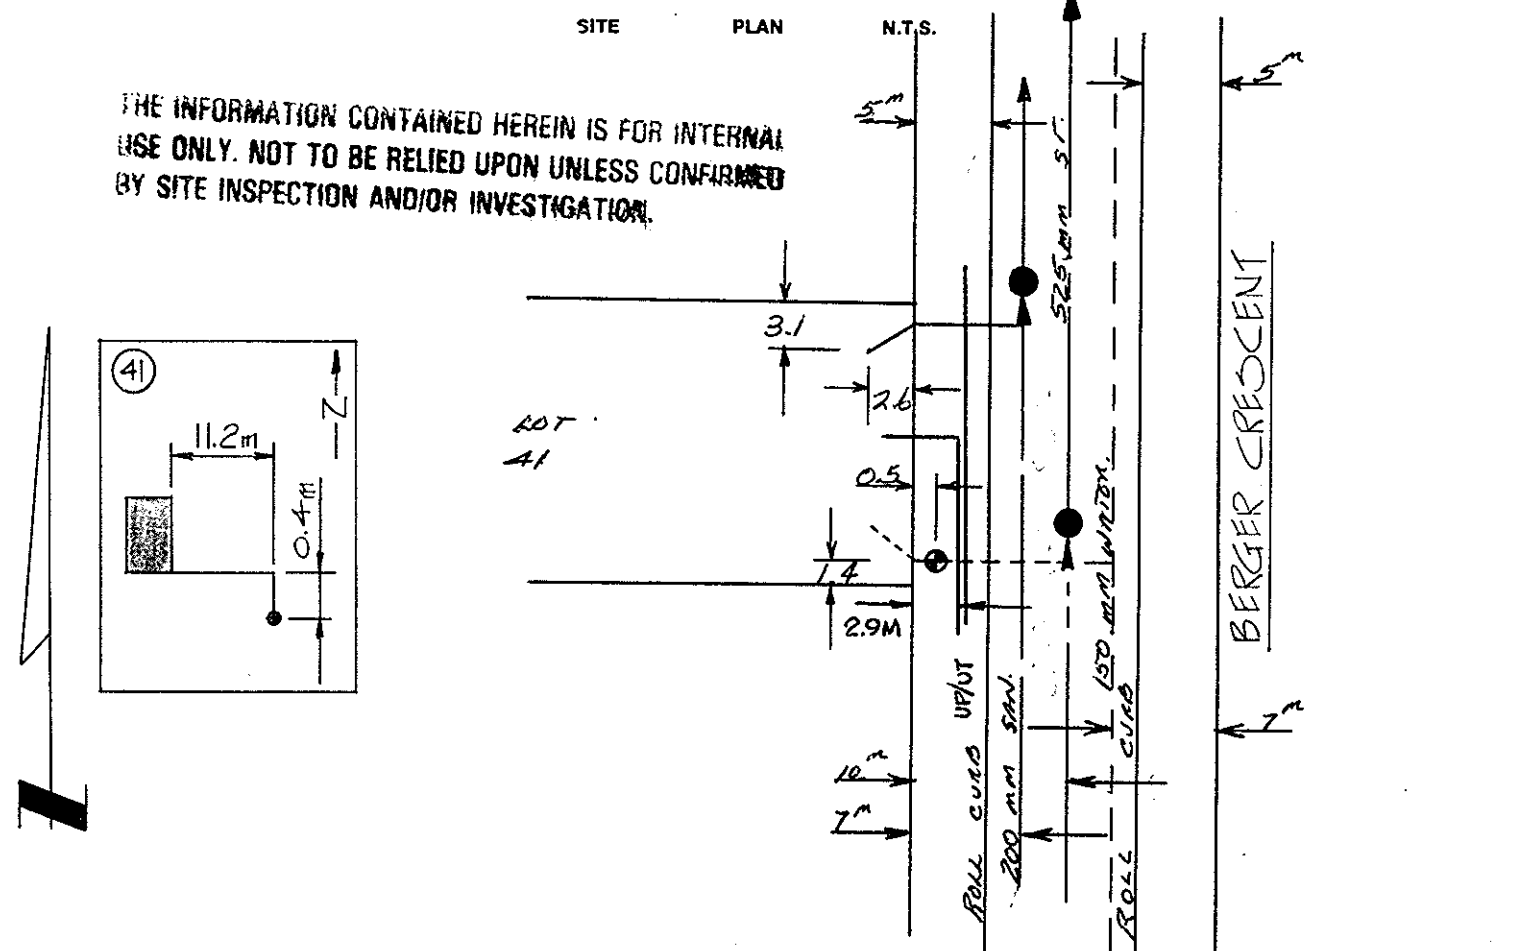

THE INFORMATION CONTAINED HEREIN IS FOR INTERNAL USE ONLY. NOT TO BE RELIED UPON UNLESS CONFIRMED BY SITE INSPECTION AND/OR INVESTIGATION.