



City of Prince George
History Sheet

PID:	006352111
SD/MU:	
WO:	5000221

Civic Address: 7638 Loyola Dr

Legal Description: Lot: 46 District Lot: 754 Plan: 21798


Service Type	Diameter (mm)	Material	Invert Elev at main (m)	Invert Elev at property line (m)	Invert Elev at service end (m)	Distance into property (m)	Installation Date
Sanitary	100mm	AC	-	612.94	-	-	November 1975
Water	20mm	Copper	-	612.99	-	-	December 1975
Storm	N/A	N/A	-	-	-	-	

Service Connection Location				Sanitary (m)	Storm (m)
Distance from downstream San MH	4426	towards upstream San MH	4488	84.98	
Distance from downstream Stm MH	-	towards upstream Stm MH	-		

Power	Size	Communications	Size	Cable	Size	Gas	Size
BC Hydro	-	Telus	-	Shaw	-	FortisBC	-
Underground Service		Underground Service		Underground Service			

Installed by:	City of Prince George forces	Survey Date:	-
Comments:	Maintenance performed on sanitary service on November 2014		

NOT TO SCALE The information contained herein is for internal use only.
Not to be relied on unless confirmed by site inspection and/or investigation.

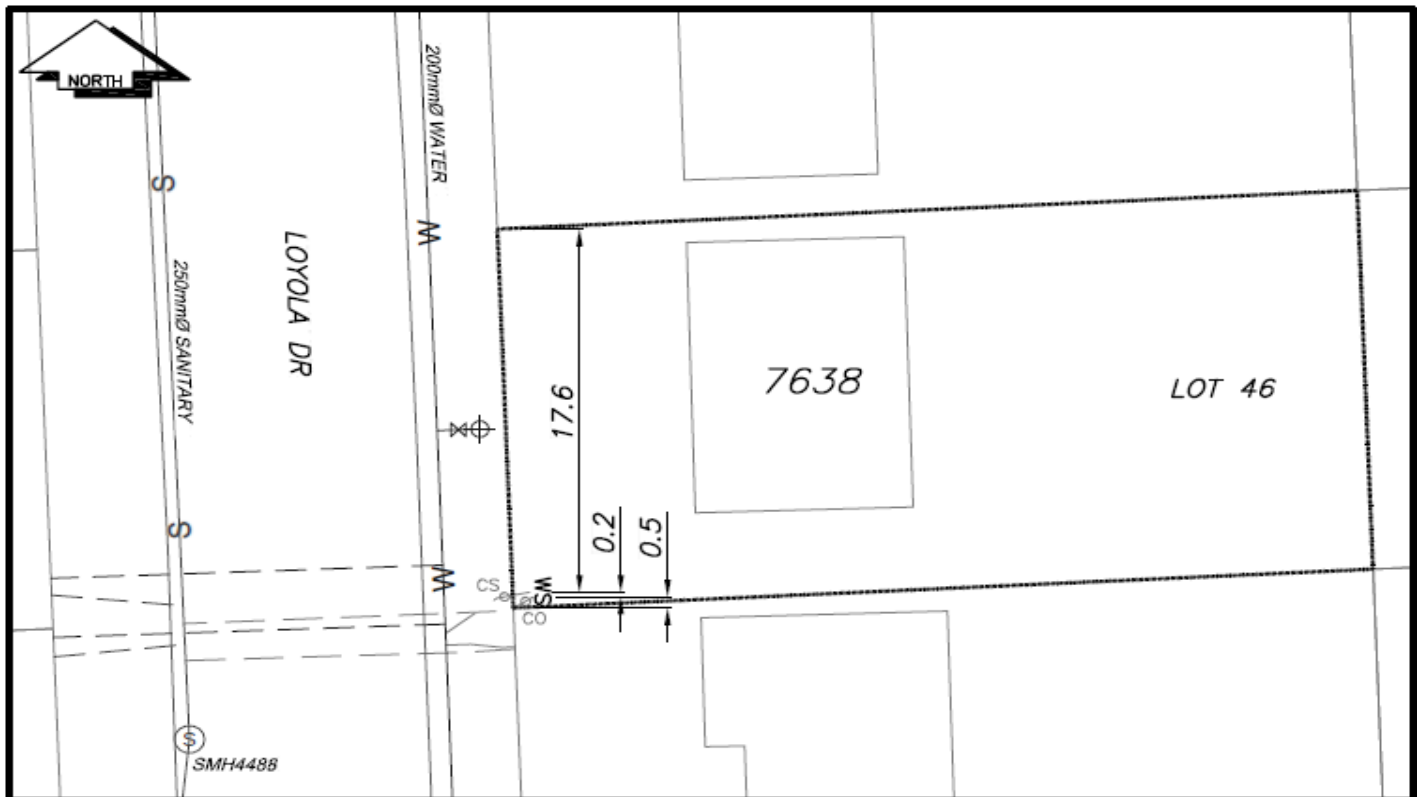

LEGEND:	
CS ^o CURB STOP	—W— WATER SERVICE
CO ^o CLEAN OUT	- - - - -S SANITARY SERVICE
⊗ WATER VALVE	⊗ FIRE HYDRANT
	—G— GAS
	- - - - - ENCUMBRANCE

NOT TO SCALE