

# City of Prince George HISTORY SHEET

SHEET NUMBER

Roll Number *006 396 551*

Legal: LOT'S *4* BLOCK D.L. *632* PLAN *21639*

Address: *2013 NORTH BLACKBURN ROAD*

Sanitary Connection: # *11328* SIZE *100mm* MATERIAL *A.C.* INV. \_\_\_\_\_ CONNECTED

Water Connection # *11328* SIZE *20mm* MATERIAL *COPPER* METER \_\_\_\_\_ CONNECTED

Storm Connection: # \_\_\_\_\_ SIZE \_\_\_\_\_ MATERIAL \_\_\_\_\_ INV. \_\_\_\_\_ CONNECTED

Cash Receipt No's: WATER \_\_\_\_\_ SANITARY *0333* STORM \_\_\_\_\_

CURB FROM PROPERTY LINE \_\_\_\_\_ PAVEMENT WIDTH \_\_\_\_\_

B.C. HYDRO \_\_\_\_\_ UNDERGROUND CONNECTION \_\_\_\_\_


B.C. TELEPHONE \_\_\_\_\_ UNDERGROUND CONNECTION \_\_\_\_\_

INLAND GAS \_\_\_\_\_

Information Sheets: \_\_\_\_\_

Comments: \_\_\_\_\_

SITE PLAN N.T.S.

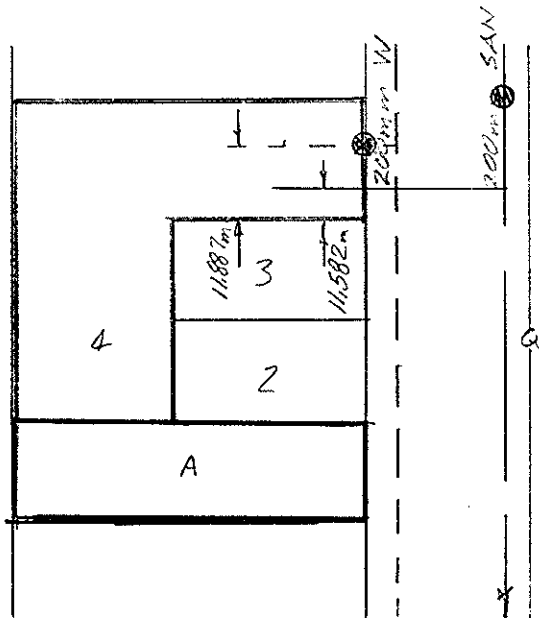

NORTH BLACKBURN RD