

City of Prince George HISTORY SHEET

300 30 30.11.11
637-24

SHEET NUMBER **Nº 1070** Roll Number

Legal: LOT'S 23-24 BLOCK 36 D.L. 1429 PLAN 646

Address: 850 IRWIN ST.

Sanitary Connection: # 3865 SIZE _____ MATERIAL _____ INV. _____ CONNECTED _____

Water Connection # 1583 SIZE 19mm MATERIAL COPPER METER _____ CONNECTED _____

Storm Connection: # _____ SIZE _____ MATERIAL _____ INV. _____ CONNECTED _____

Cash Receipt No's: WATER _____ SANITARY 1782 STORM _____

CURB FROM PROPERTY LINE _____ PAVEMENT WIDTH _____

B.C. HYDRO _____ UNDERGROUND CONNECTION _____




B.C. TELEPHONE _____ UNDERGROUND CONNECTION _____

INLAND GAS _____

Information Sheets: _____

Comments: _____

SITE PLAN N.T.S.

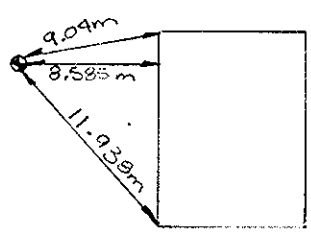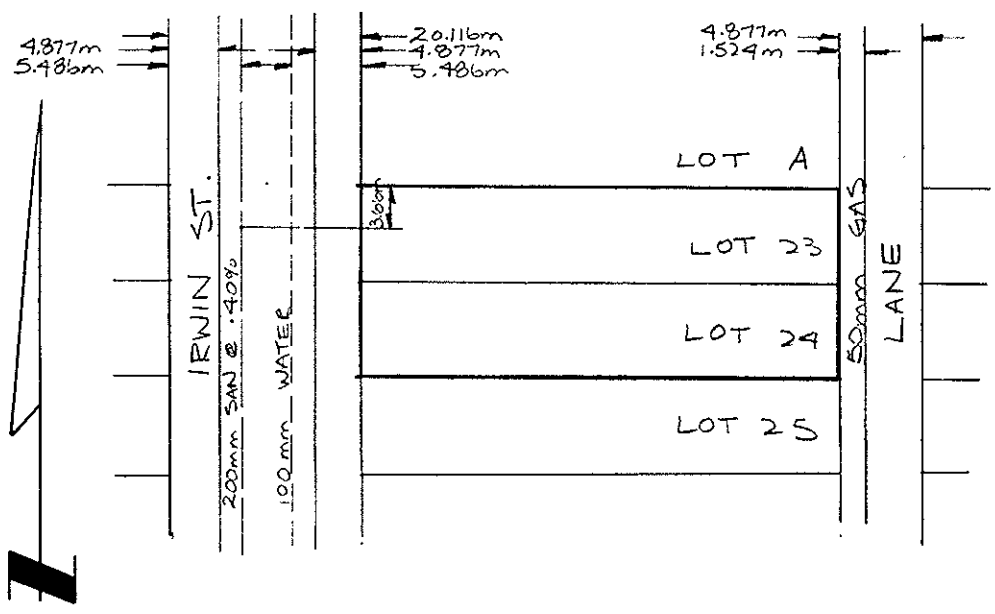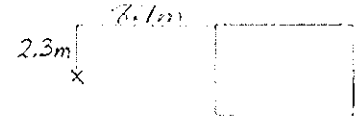

REPORT TO RECORDS

WATER SERVICE INFORMATION

Lot No. _____ Block _____ D.L. _____


Address 850 Irwin

Size of Connection 1/2" 3/4" Other _____

Type of Connection Copper Iron

Thaw Wire Yes No

LOCATION SKETCH

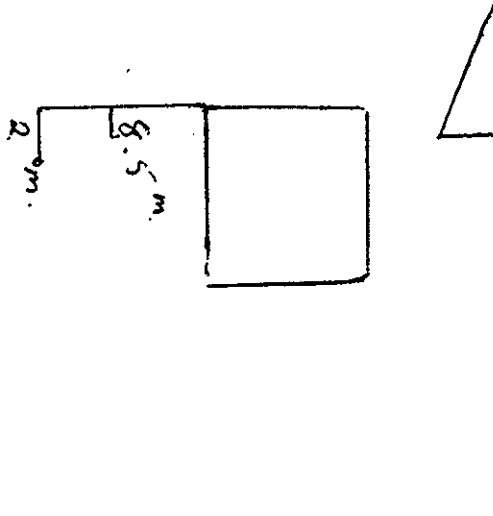

Field Location By R.C. Date 6/8/92

Checked by: _____