

**City of Prince George
HISTORY SHEET**

JOB: 111010
009039619

JK

SHEET NUMBER

Roll Number

Legal: LOT'S F-F BLOCK 13 D.L. 932 PLAN 22118

Address: 1475 - 1479 MILBURN AVE

Sanitary Connection: # 100 mm MATERIAL A.C INV. CONNECTED
 SIZE 100 mm

Water Connection # 20 mm MATERIAL COPPER METER CONNECTED
 SIZE 20 mm

Storm Connection: # MATERIAL INV. CONNECTED
 SIZE

Cash Receipt No's: WATER SANITARY STORM

CURB FROM PROPERTY LINE 4.877 m PAVEMENT WIDTH 10.363 m

B.C. HYDRO O/H UNDERGROUND CONNECTION



B.C. TELEPHONE O/H UNDERGROUND CONNECTION

INLAND GAS AS SHOWN

Information Sheets:

Comments:

**THE INFORMATION CONTAINED HEREIN IS FOR INTERNAL USE ONLY.
NOT TO BE RELIED UPON UNLESS CONFIRMED BY SITE INSPECTION AND/OR INVESTIGATION**

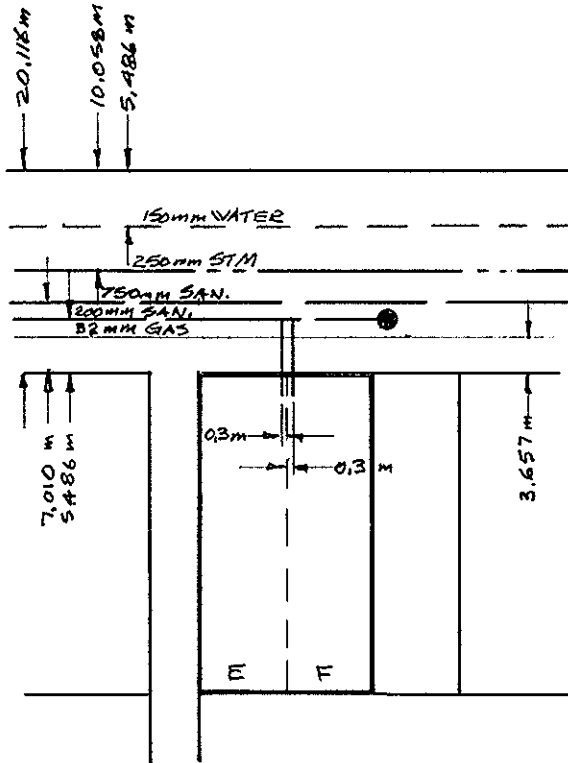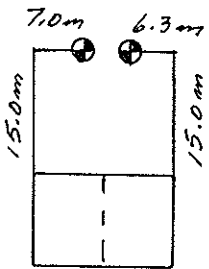

MILBURN AVE.

