

# City of Prince George HISTORY SHEET

SHEET NUMBER **5303** Roll Number

Legal: LOT'S **7 & 8** BLOCK **240** D.L. **343** PLAN **1268**

Address: **1569 HEMLOCK ST.**

Sanitary Connection: # **3477** SIZE MATERIAL INV. **1887.90** CONNECTED

Water Connection # **383** SIZE **1/2"** MATERIAL METER CONNECTED

Storm Connection: # SIZE MATERIAL INV. CONNECTED

Cash Receipt No's: WATER SANITARY STORM

CURB FROM PROPERTY LINE PAVEMENT WIDTH


B.C. HYDRO **OH** UNDERGROUND CONNECTION

B.C. TELEPHONE **OH** UNDERGROUND CONNECTION

INLAND GAS **AS SHOWN**

Information Sheets:

Comments:

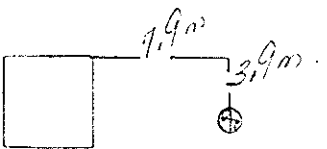

SITE PLAN N.T.S.

