

City of Prince George HISTORY SHEET

SHEET NUMBER **5303** Roll Number

Legal: LOT'S **7 & 8** BLOCK **240** D.L. **343** PLAN **1268**

Address: **1569 HEMLOCK ST.**

Sanitary Connection: # **3477** SIZE _____ MATERIAL _____ INV. **1887.90** CONNECTED

Water Connection # **383** SIZE **1/2"** MATERIAL _____ METER _____ CONNECTED

Storm Connection: # _____ SIZE _____ MATERIAL _____ INV. _____ CONNECTED

Cash Receipt No's: WATER _____ SANITARY _____ STORM _____

CURB FROM PROPERTY LINE _____ PAVEMENT WIDTH _____


B.C. HYDRO **OH.** UNDERGROUND CONNECTION _____

B.C. TELEPHONE **OH.** UNDERGROUND CONNECTION _____

INLAND GAS **AS SHOWN**

Information Sheets: _____

Comments: _____

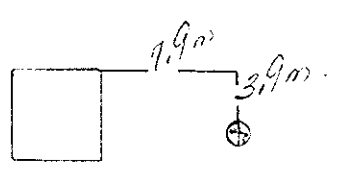

SITE PLAN N.T.S.

