

City of Prince George HISTORY SHEET

006491847
855

SHEET NUMBER **Nº 1136** Roll Number

Legal: LOT'S **8-9** BLOCK **49** D.L. **1429** PLAN **646**

Address: **837 IRWIN ST.**

Sanitary Connection: # **2728** SIZE **100mm** MATERIAL **INV.** **CONNECTED**

Water Connection # **1675** SIZE **13mm** MATERIAL **METER** **CONNECTED**

Storm Connection: # **SIZE** MATERIAL **INV.** **CONNECTED**

Cash Receipt No's: WATER **SANITARY 3366** STORM

CURB FROM PROPERTY LINE PAVEMENT WIDTH

B.C. HYDRO UNDERGROUND CONNECTION


B.C. TELEPHONE UNDERGROUND CONNECTION

INLAND GAS

Information Sheets:

Comments:


SITE PLAN N.T.S.

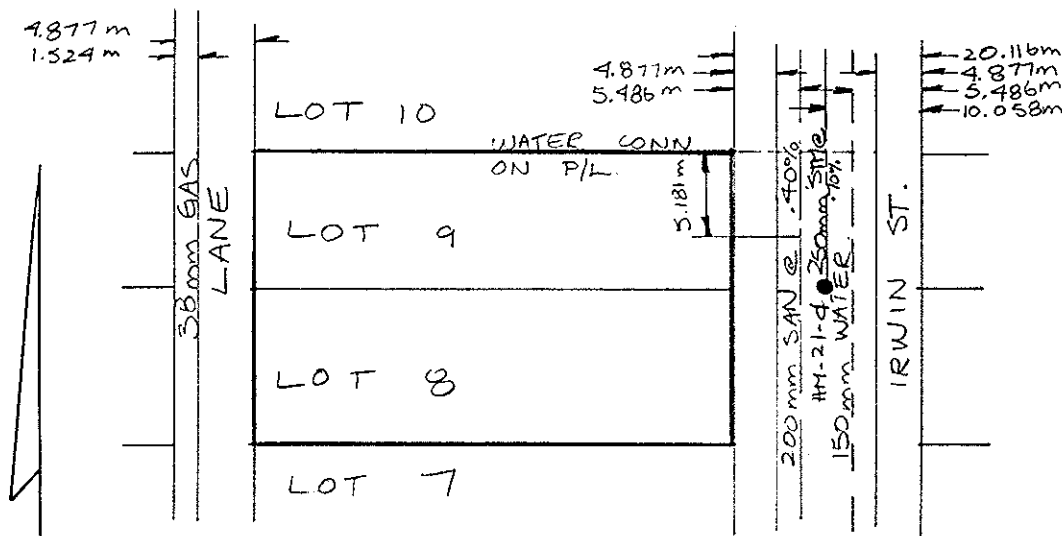

006 491847

REPORT TO RECORDS**WATER SERVICE INFORMATION**

Lot No. _____ Block _____ D.L. _____

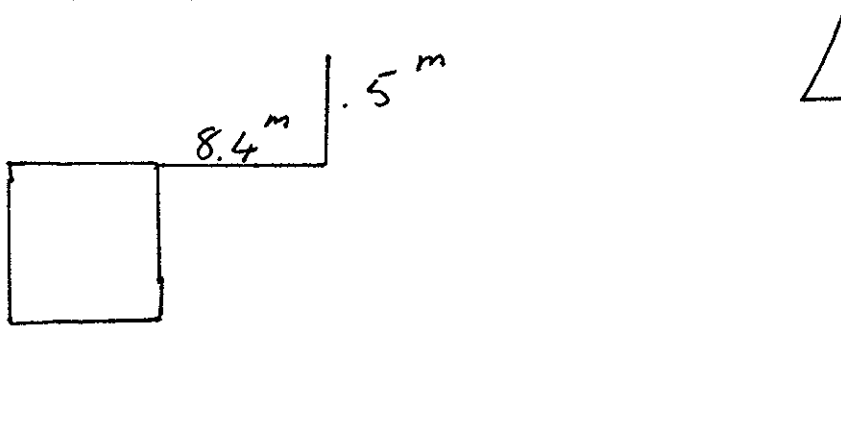Address 837 IrwinSize of Connection ½" ¾" Other _____Type of Connection Copper IronThaw Wire Yes No**LOCATION SKETCH**Field Location By G.C. Date 6/8/92

Checked by: _____