

City of Prince George HISTORY SHEET

006491847
855

SHEET NUMBER **N^o 1136** Roll Number

Legal: LOT'S **B-9** BLOCK **49** D.L. **1429** PLAN **646**

Address: **837 IRWIN ST.**

Sanitary Connection: # **2728** SIZE **100mm** MATERIAL **INV.** **CONNECTED**

Water Connection # **1625** SIZE **13mm** MATERIAL **METER** **CONNECTED**

Storm Connection: # **SIZE** MATERIAL **INV.** **CONNECTED**

Cash Receipt No's: WATER **SANITARY 3366** STORM

CURB FROM PROPERTY LINE PAVEMENT WIDTH

B.C. HYDRO UNDERGROUND CONNECTION


B.C. TELEPHONE UNDERGROUND CONNECTION

INLAND GAS

Information Sheets:

Comments:

SITE PLAN N.T.S.

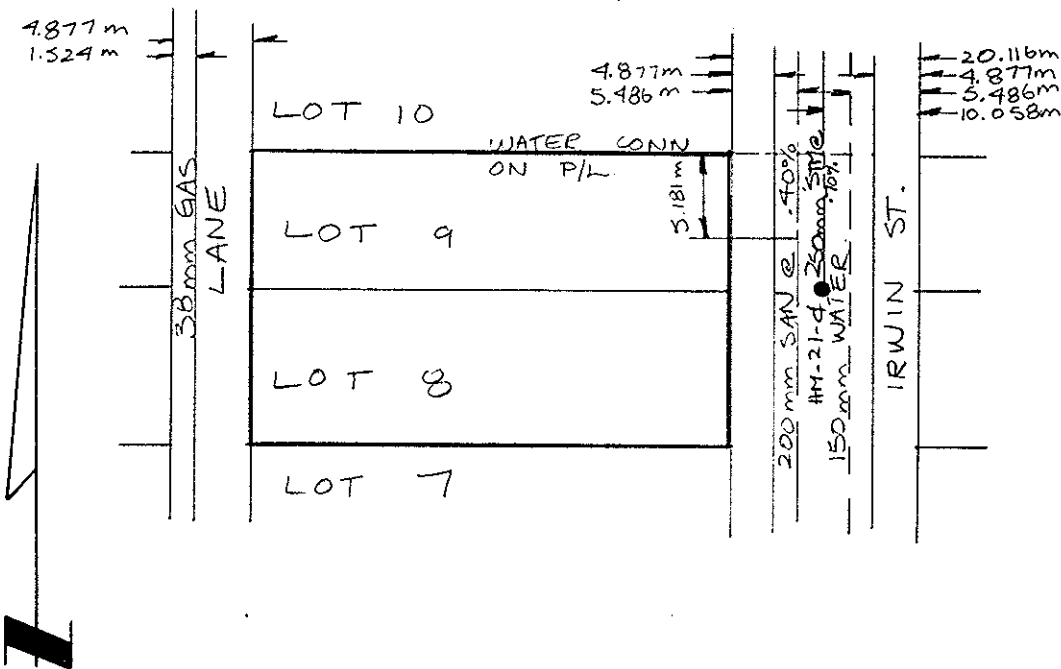

006 491847

REPORT TO RECORDS

WATER SERVICE INFORMATION

Lot No. _____ Block _____ D.L. _____


Address 837 Irwin

Size of Connection 1/2" 3/4" Other _____

Type of Connection Copper Iron

Thaw Wire Yes No

LOCATION SKETCH

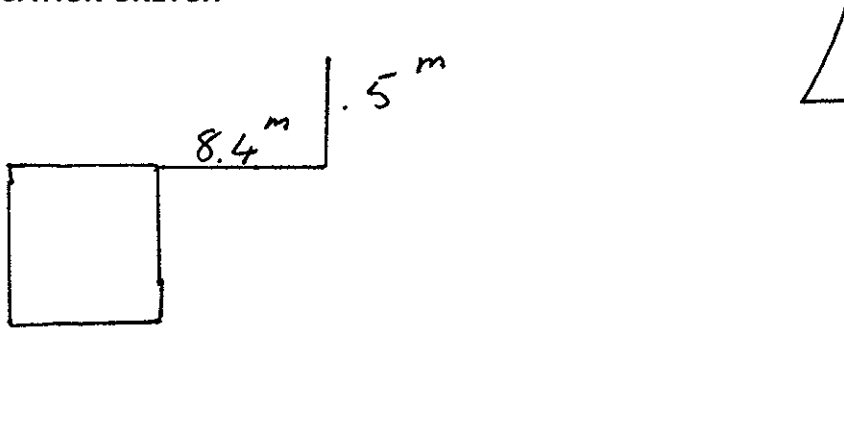

Field Location By G.C. Date 6/8/92

Checked by: _____